



TOTAL SF AVAILABLE - 17,684 RSF

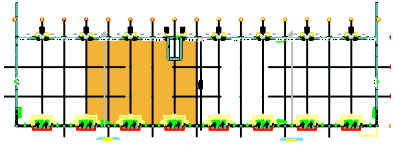

Key Plan

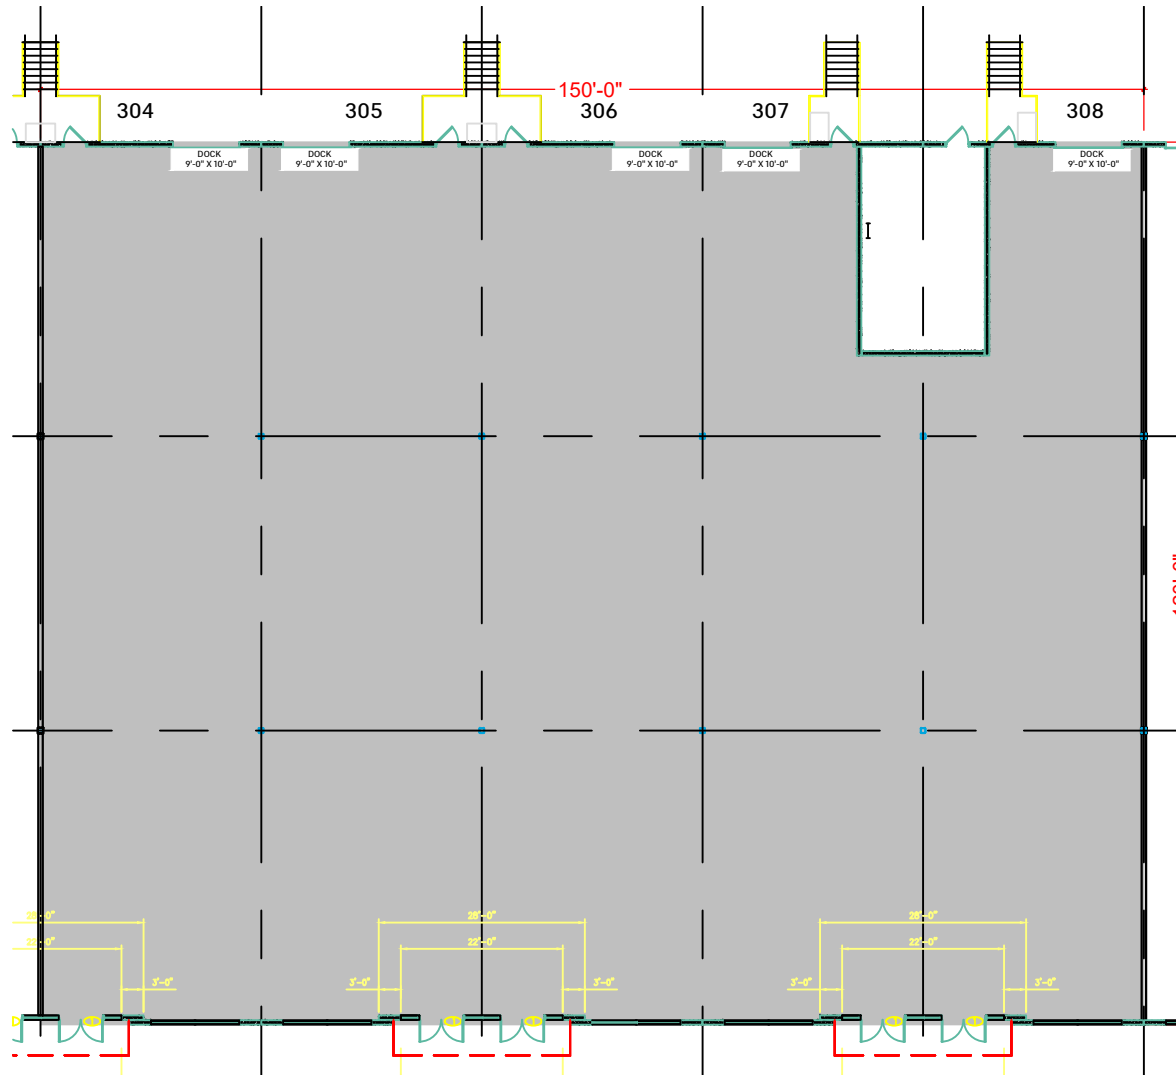

Floor Plan