



TOTAL SF AVAILABLE -17,888 RSF

OFFICE - 1,300 RSF

WAREHOUSE - 16,588 RSF

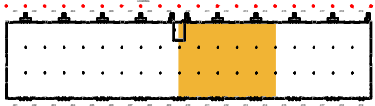

Key Plan

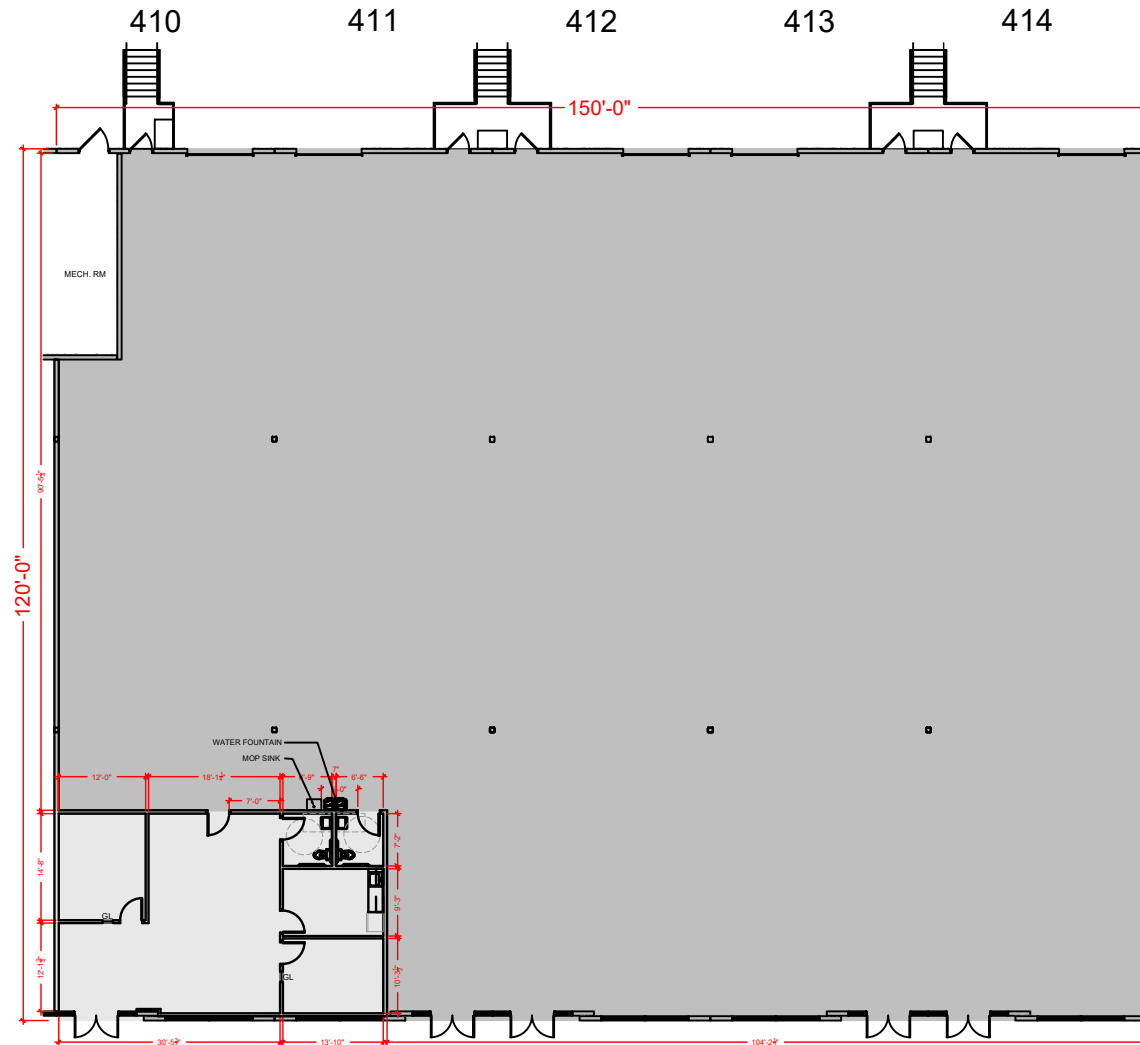

Floor Plan