


LEASE EXP.

- AVAILABLE
- TBD
- 2023
- 2024
- 2025
- 2026
- 2027
- 2028
- 2029
- 2030+
- UTILITY

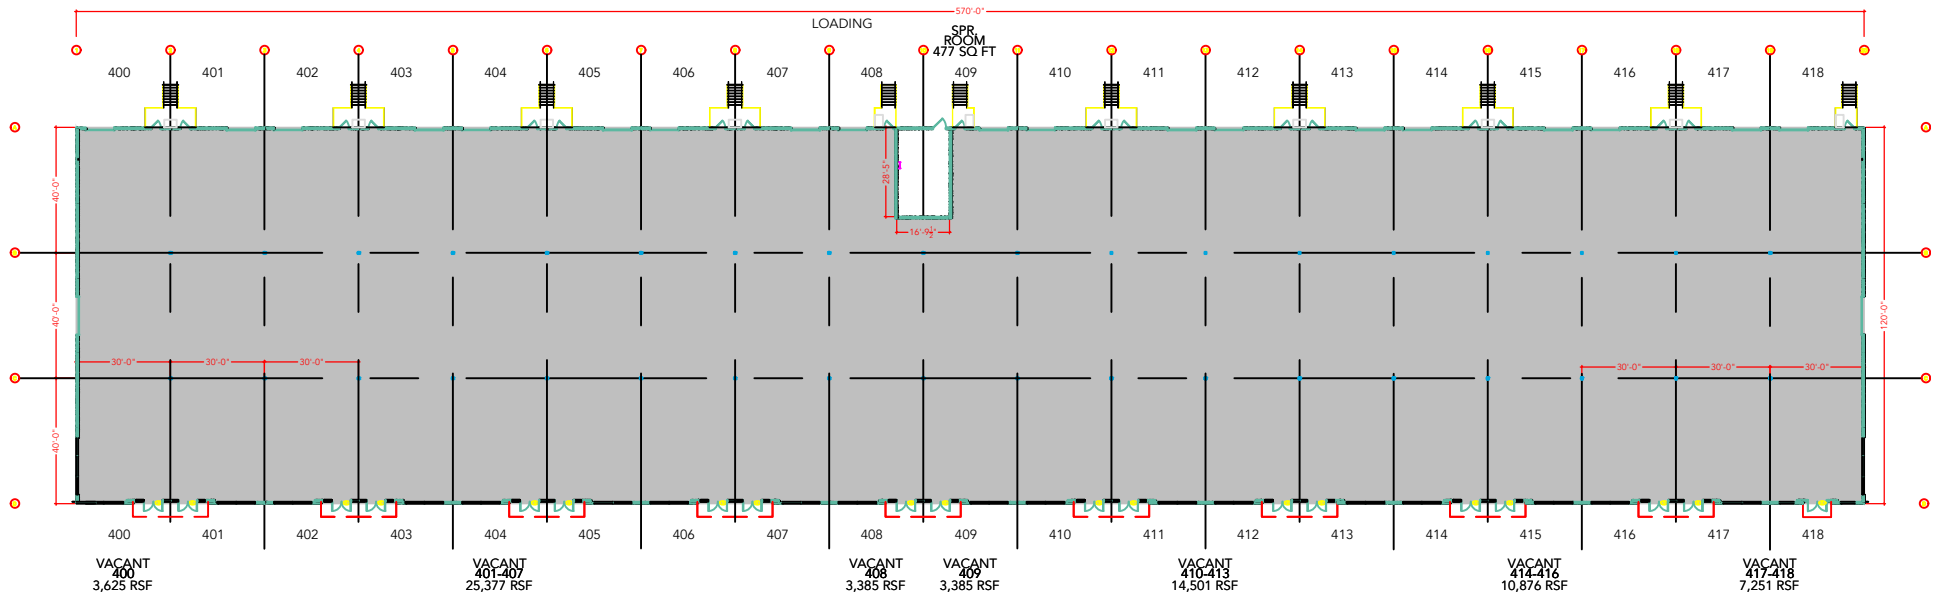

**AREA**

68,400 TOTAL BLDG SQFT

PLAN MAY NOT REPRESENT CURRENT BUILD-OUT:  
REFER TO INDIVIDUAL AS-BUILT PLANS FOR DATE OF FIELD VERIFICATION.

PLAN NOT TO SCALE - THIS IS NOT A CONSTRUCTION DOCUMENT

**IMESON LANDING BUSINESS PARK**

IMESON PARK BLVD,  
JACKSONVILLE, FL 32218  
JAIM 4 BLDG STACKING PLAN

**ASBUILT AVAILABLE BLDG PLAN**

DATE: 4/21/2023  
ASBUILT DRAWN BY: xx  
DRAWING #: JAIM4-BLDG



2066 LORD BALTIMORE DRIVE BALTIMORE, MD 21244  
PHONE 410-298-2600 FAX: 410-298-9644  
www.MerrittProperties.com