


LEASE EXP.

- AVAILABLE
- TBD
- 2023
- 2024
- 2025
- 2026
- 2027
- 2028
- 2029
- 2030+
- UTILITY

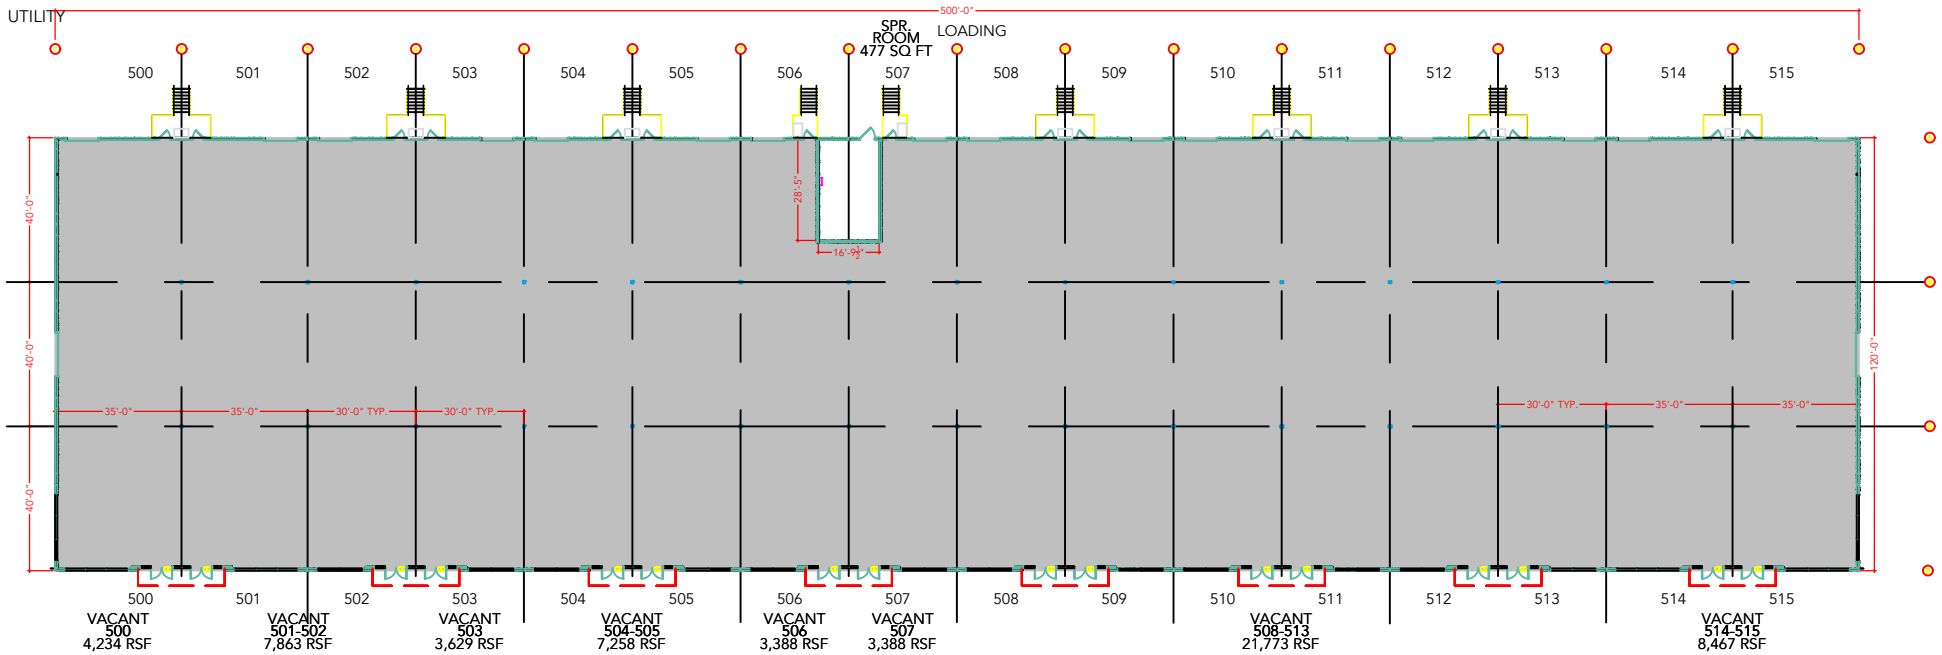

AREA

60,000 TOTAL BLDG SQFT

PLAN MAY NOT REPRESENT CURRENT BUILD-OUT:
REFER TO INDIVIDUAL AS-BUILT PLANS FOR DATE OF FIELD VERIFICATION.

PLAN NOT TO SCALE - THIS IS NOT A CONSTRUCTION DOCUMENT

IMESON LANDING BUSINESS PARK
IMESON PARK BLVD,
JACKSONVILLE, FL 32218
JAIM 5 BLDG STACKING PLAN

ASBUILT AVAILABLE BLDG PLAN

DATE: 4/21/2023
ASBUILT DRAWN BY: xx
DRAWING #: JAIM5-BLDG



2066 LORD BALTIMORE DRIVE BALTIMORE, MD 21244
PHONE 410-298-2600 FAX: 410-298-9644
www.MerrittProperties.com