


TOTAL SF AVAILABLE - 2,919 SF


OFFICE - 2,259 SF

WAREHOUSE - 660 SF

[Click to access 3D model](#)

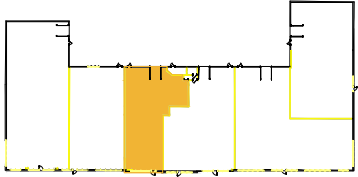

Key Plan

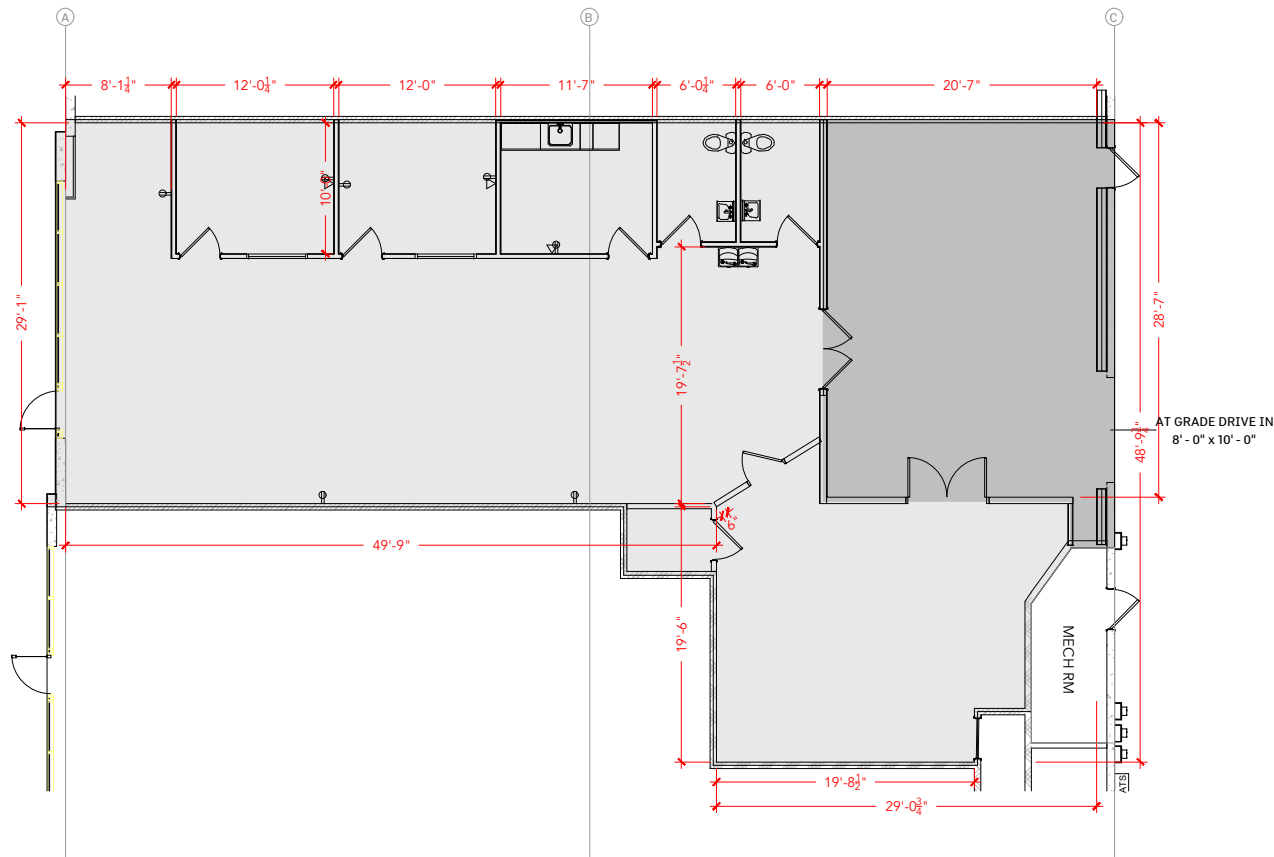

Floor Plan