


TOTAL SF AVAILABLE - 11,607 SF


OFFICE - 2,463 SF

WAREHOUSE - 9,144 SF

[Click to access 3D model](#)

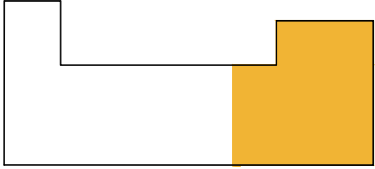

Key Plan

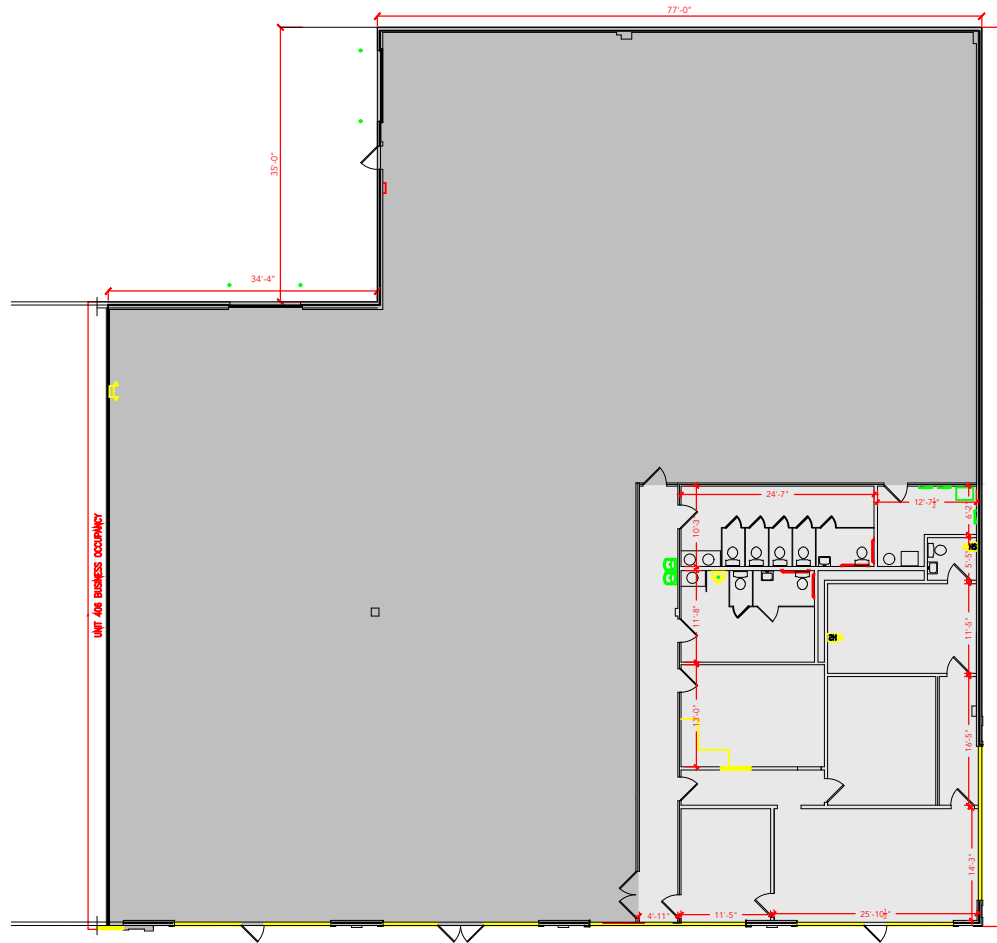

Floor Plan