



**TOTAL SF AVAILABLE -35,400 SF**

OFFICE - 5,660 SF  
 WAREHOUSE SF - 29,740 SF  
 2,380 SF. FREEZER ADDITION NOT INCLUDED IN TOTALS  
[Click to access 3D model](#)

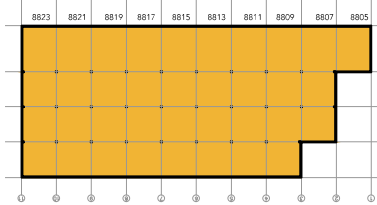

Key Plan

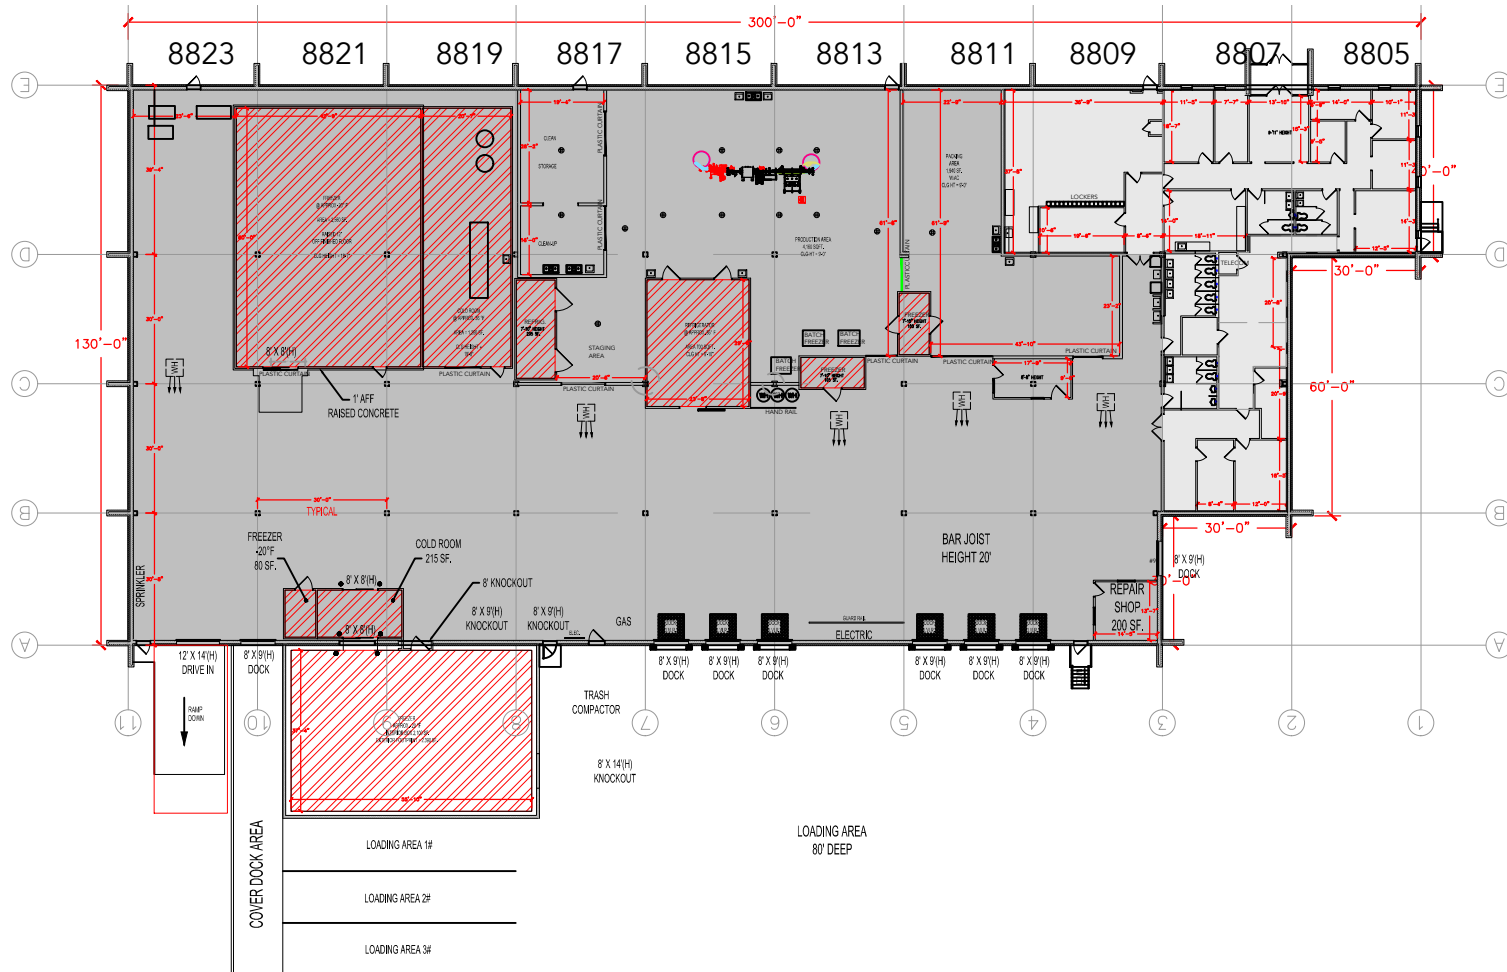

## Floor Plan