



**TOTAL SF AVAILABLE -1,807 RSF**

**OFFICE - 1,807 RSF**

**WAREHOUSE - 0,000 RSF**

\* INCLUDES % OF METER ROOM

[Click to access CADD file](#)

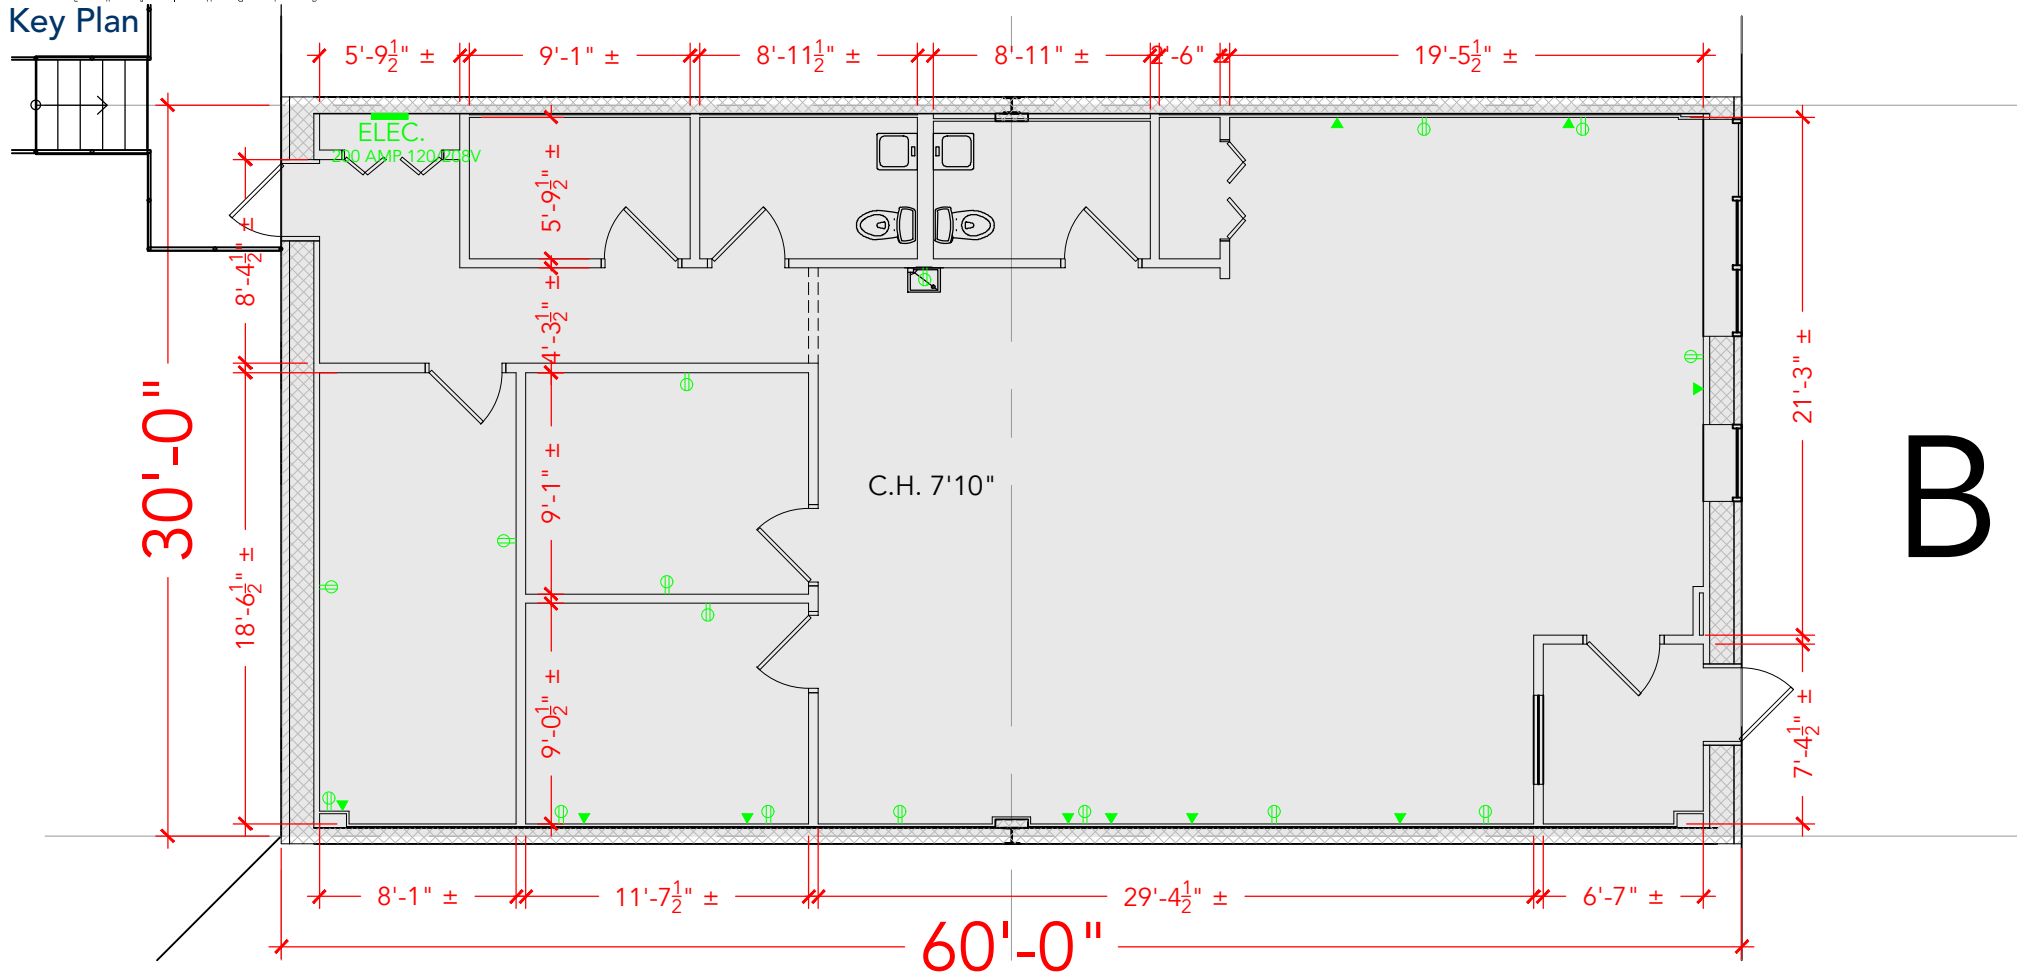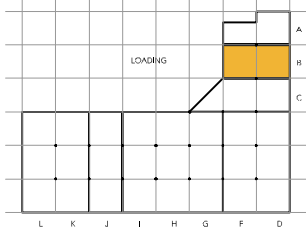

**Floor Plan**