

TOTAL SF AVAILABLE -2,149 RSF

OFFICE - 529 RSF


WAREHOUSE - 1,620 RSF

* INCLUDES % OF METER ROOM

[Click to access CADD file](#)



Key Plan

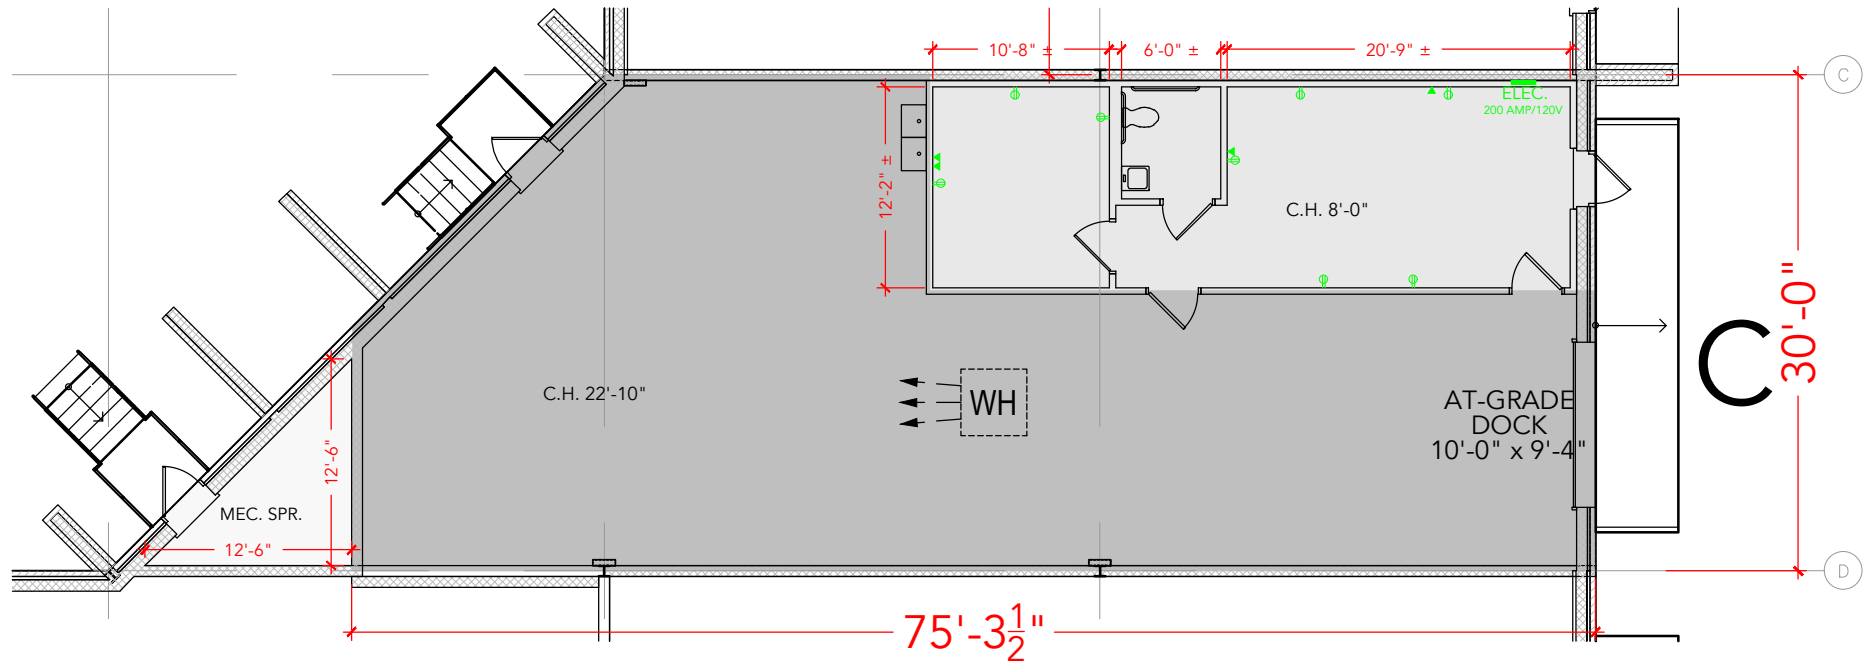

Floor Plan