


**TOTAL SF AVAILABLE -2,711 RSF**

**OFFICE - 1,019 RSF**


**WAREHOUSE - 1,692 RSF**

\* INCLUDES % OF METER ROOM

[Click to access CADD file](#)  
\* 1,037 SQFT MEZZ. NOT INCLUDED IN TOTAL SQFT

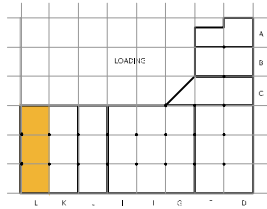

Key Plan

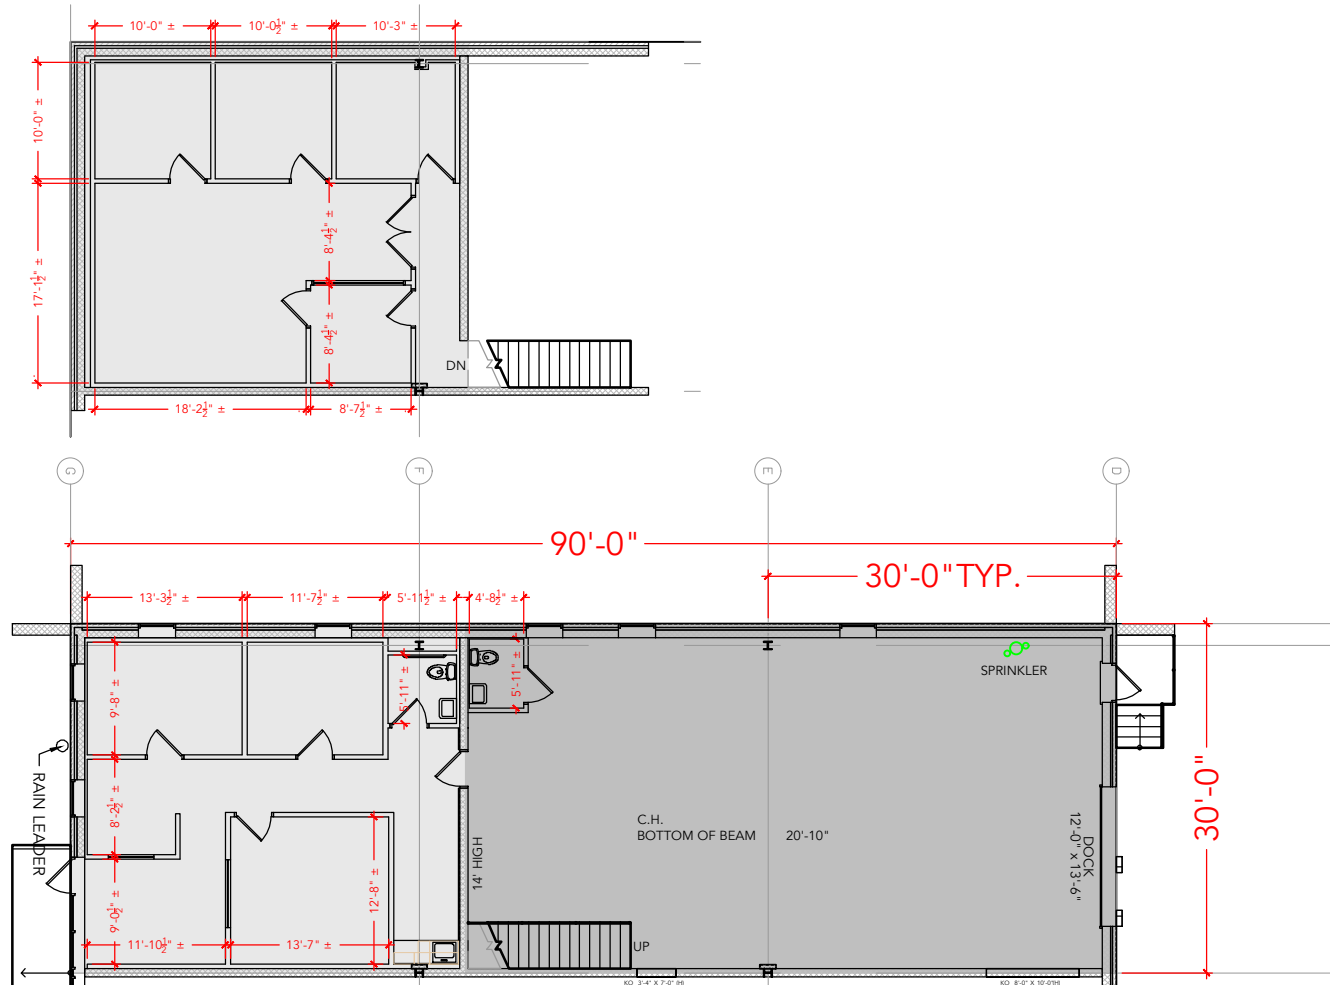

Floor Plan