


TOTAL SF AVAILABLE - 2,700 SF


OFFICE - 2,200 SF
WAREHOUSE - 500 SF

[Click to access 3D model](#)

K J I H G F E D C B A

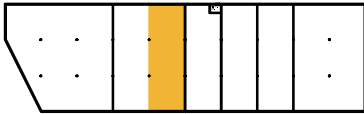

Key Plan

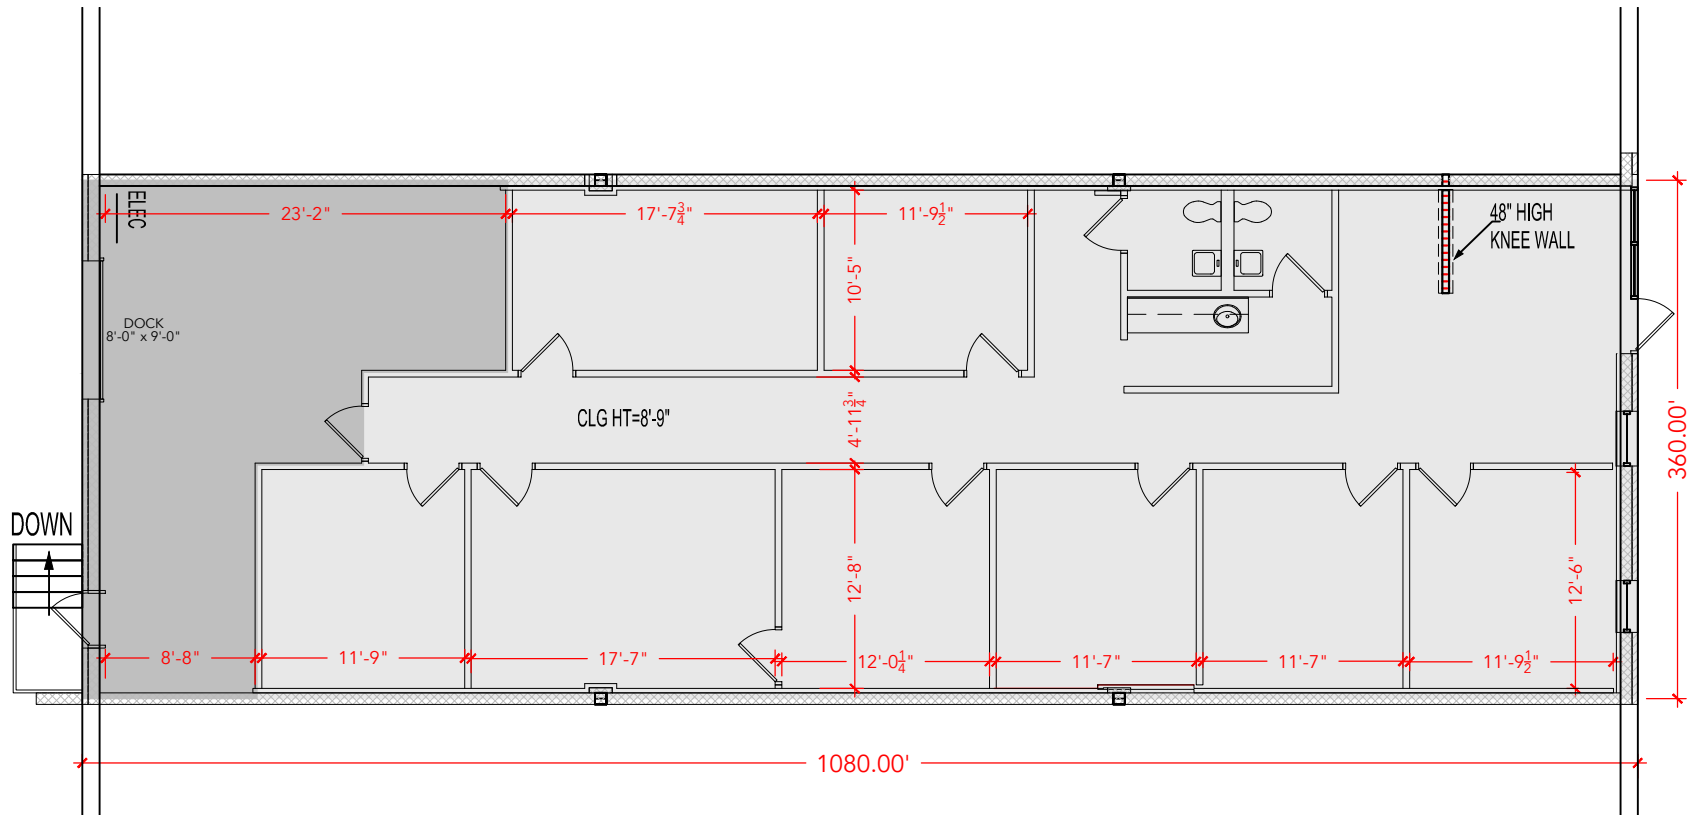

Floor Plan