



TOTAL SF AVAILABLE - 3,600 SF

OFFICE - 0,000 SF
WAREHOUSE SF - 3,600 SF

[Click to access 3D model](#)

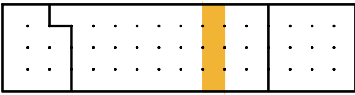

Key Plan

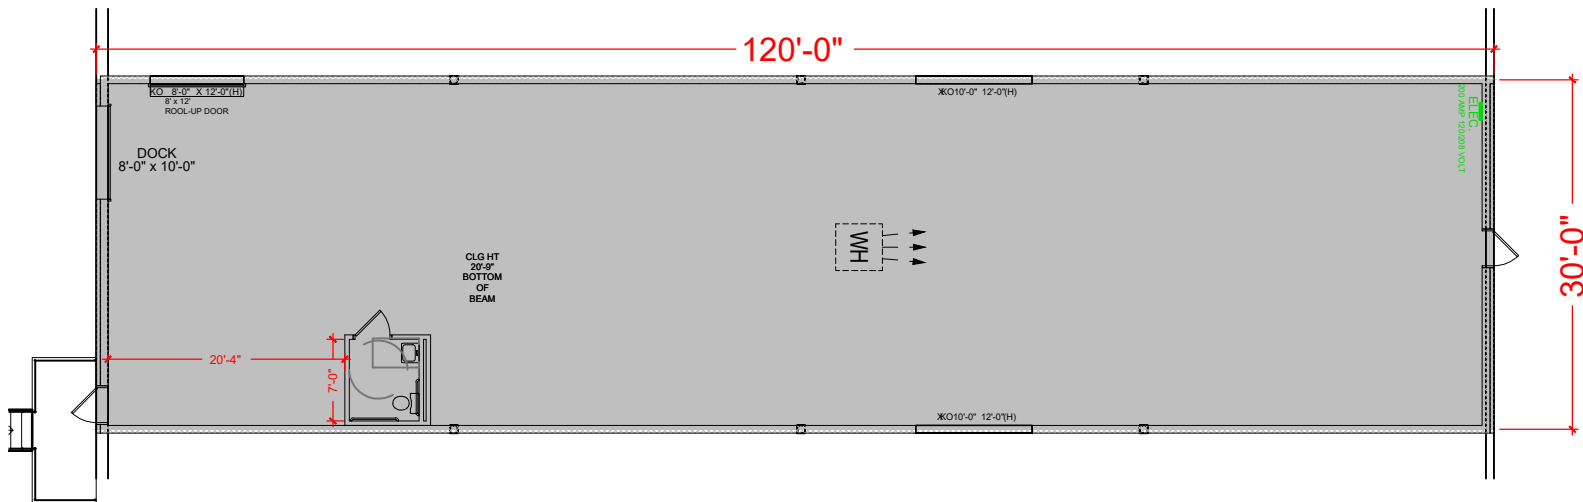

Floor Plan