



KELSO 1 & 2

8893-8899 KELSO DRIVE, BALTIMORE, MD 21221

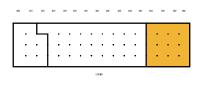


Key Plan

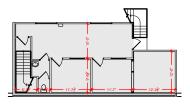

TOTAL SF AVAILABLE - 14,400 SF

OFFICE - 2,091 SF
WAREHOUSE - 12,309 SF
*939 SF MEZZ. NOT INCLUDED IN TOTAL SF
Click to access 3D model

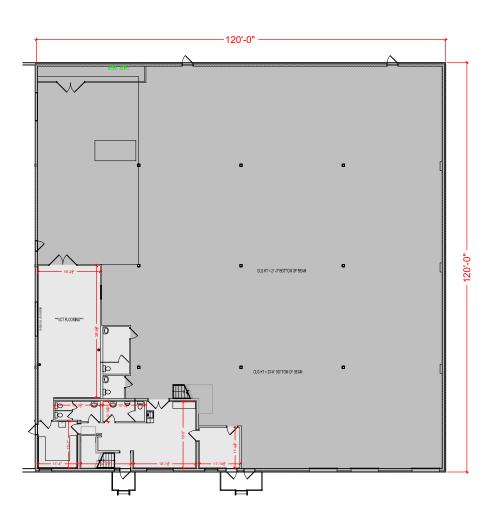

Floor Plan