


TOTAL SF AVAILABLE - 10,200 SF


OFFICE - 1,277 SF

WAREHOUSE - 8,923 SF

[Click to access 3D model](#)

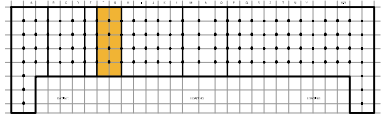

Key Plan

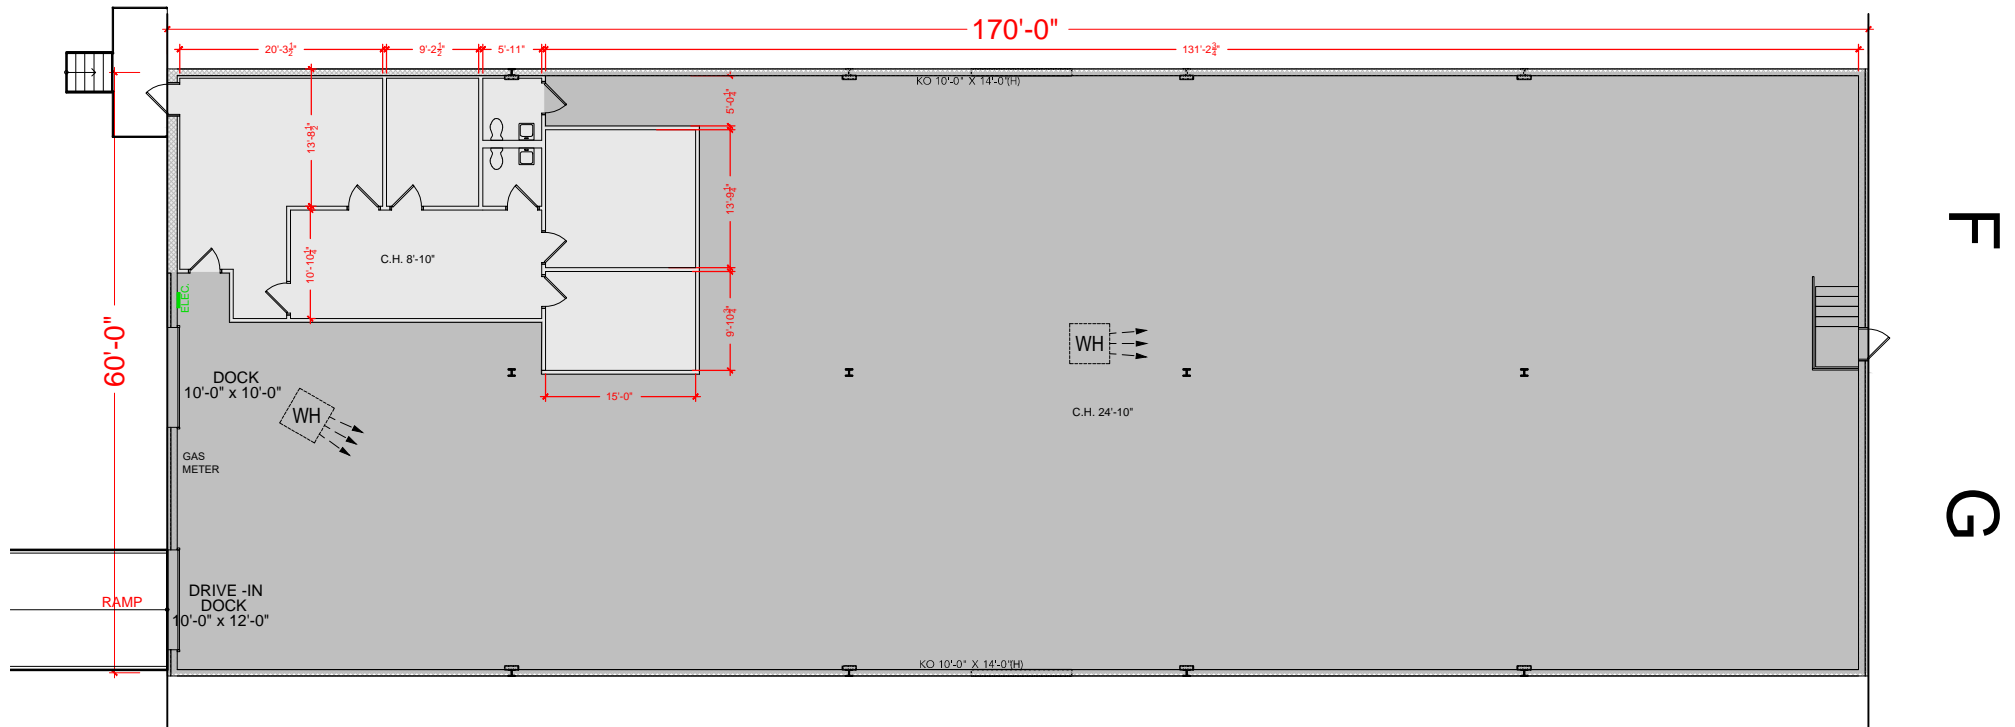

Floor Plan