



TOTAL SF AVAILABLE - 10,200 SF

OFFICE - 1,277 SF  
WAREHOUSE - 8,923 SF

[Click to access CADD file](#)

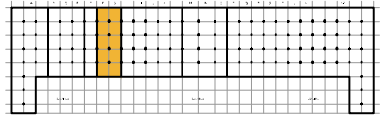

Key Plan

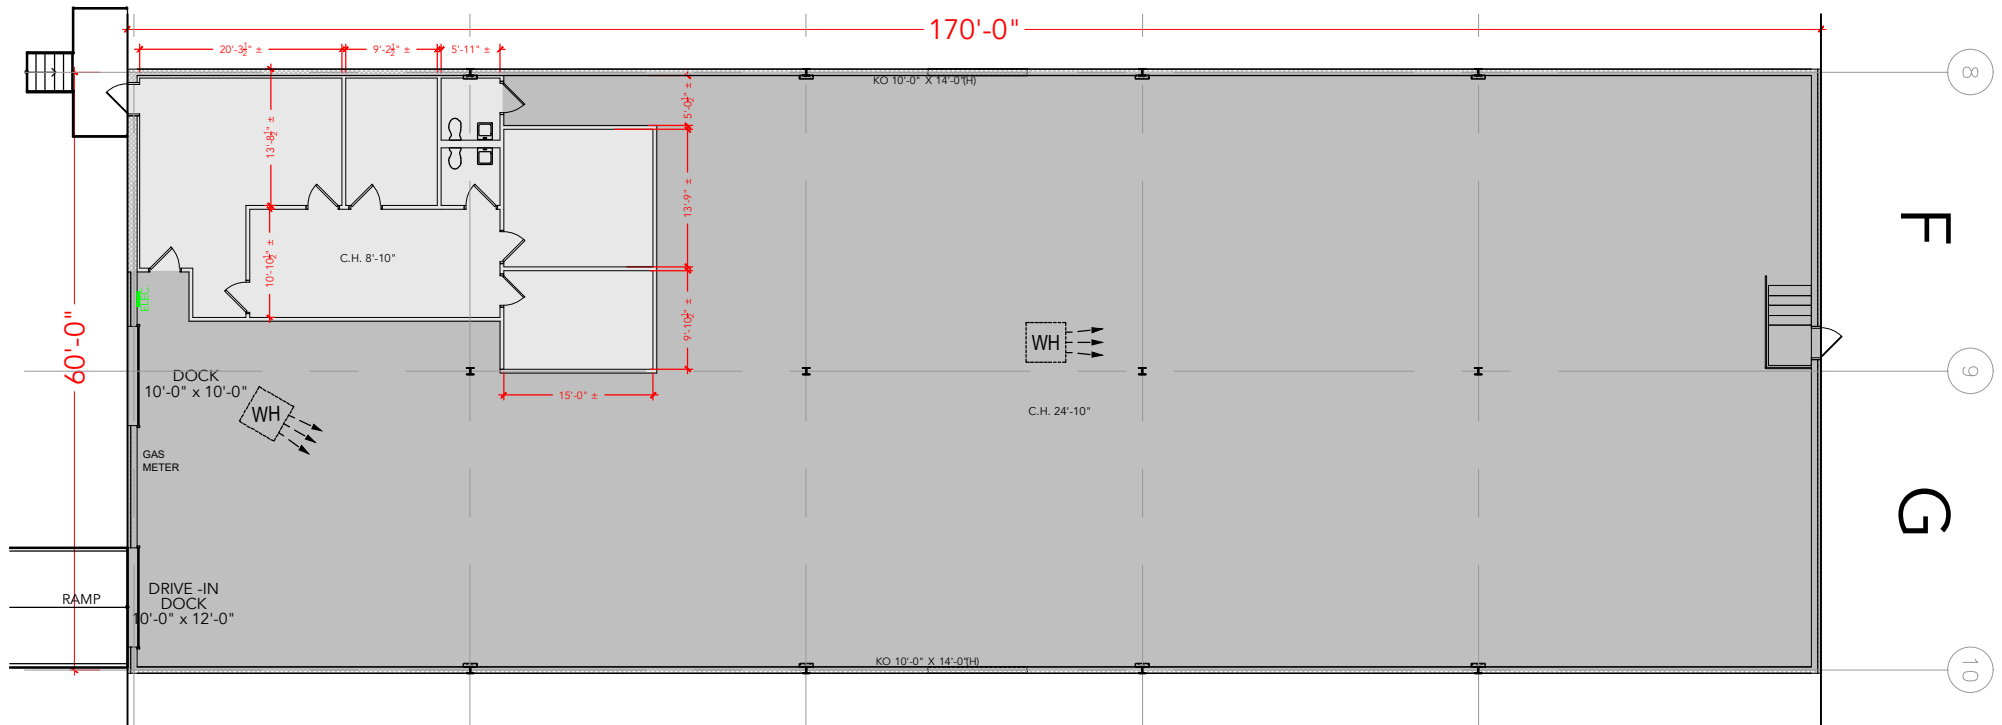

Floor Plan