



**TOTAL SF AVAILABLE -10,200 SF**

OFFICE - 1,275 SF  
WAREHOUSE - 8,925 SF

[Click to access CADD file](#)

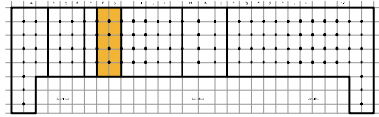

Key Plan

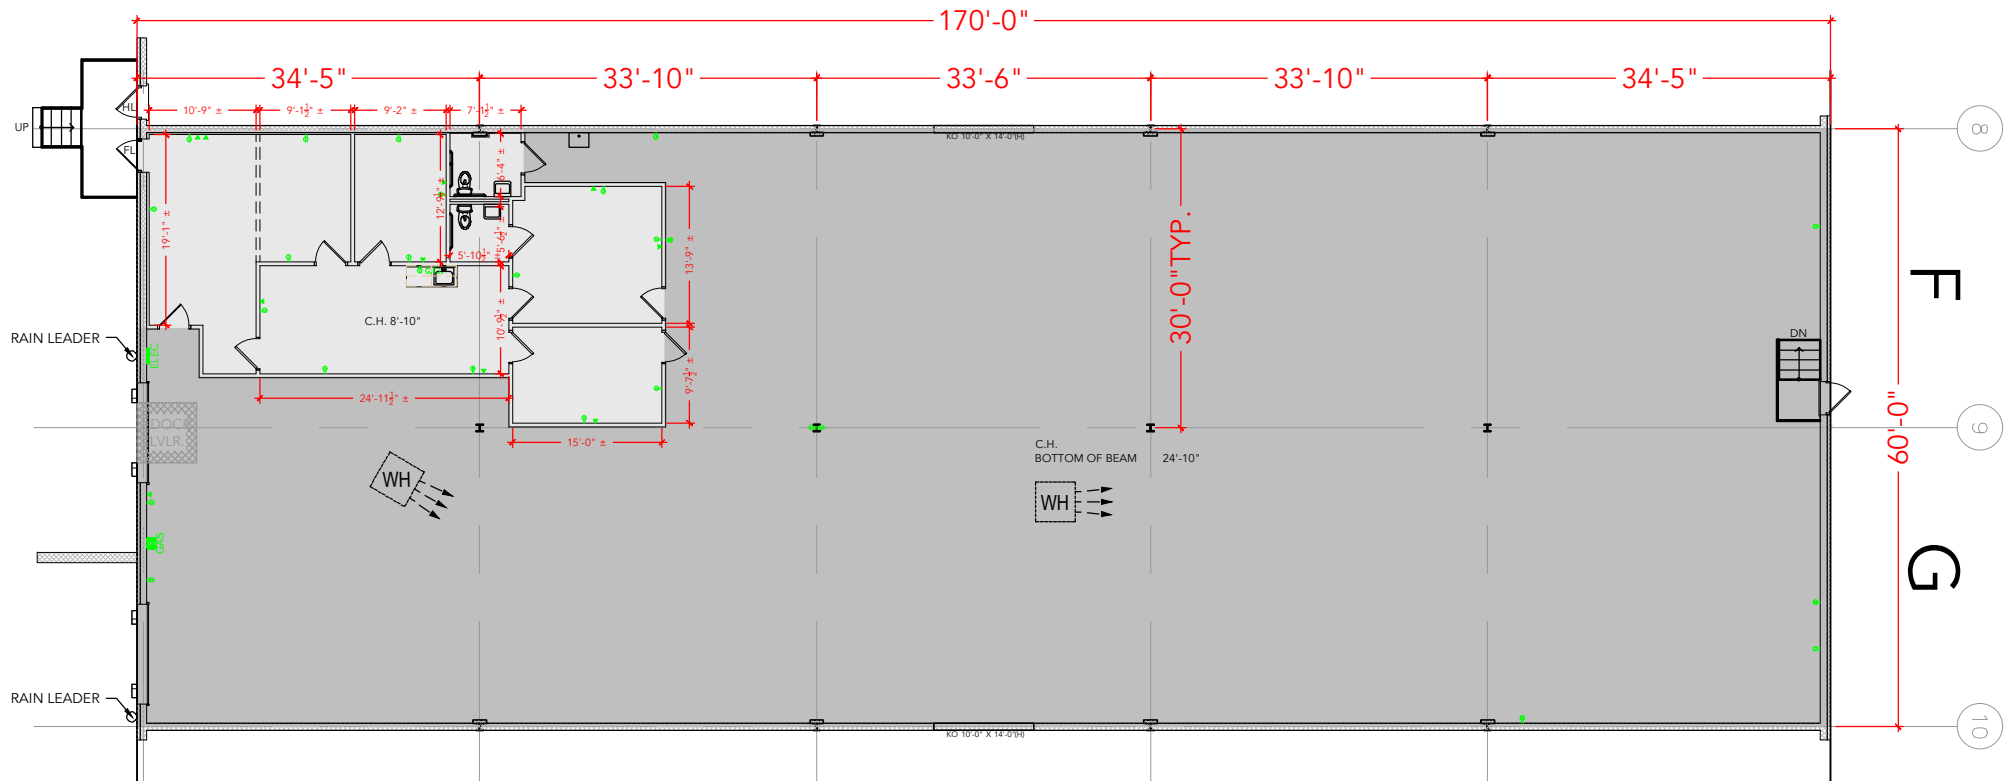

Floor Plan