


**TOTAL SF AVAILABLE - 17,100 SF**

OFFICE - 17,100 SF


WAREHOUSE SF - 0,000 SF

\* 6,156 SQFT MEZZ NOT INCLUDED IN TOTAL SQFT

[Click to access 3D model](#)

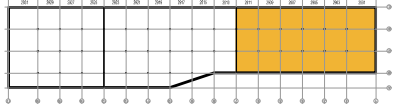

Key Plan

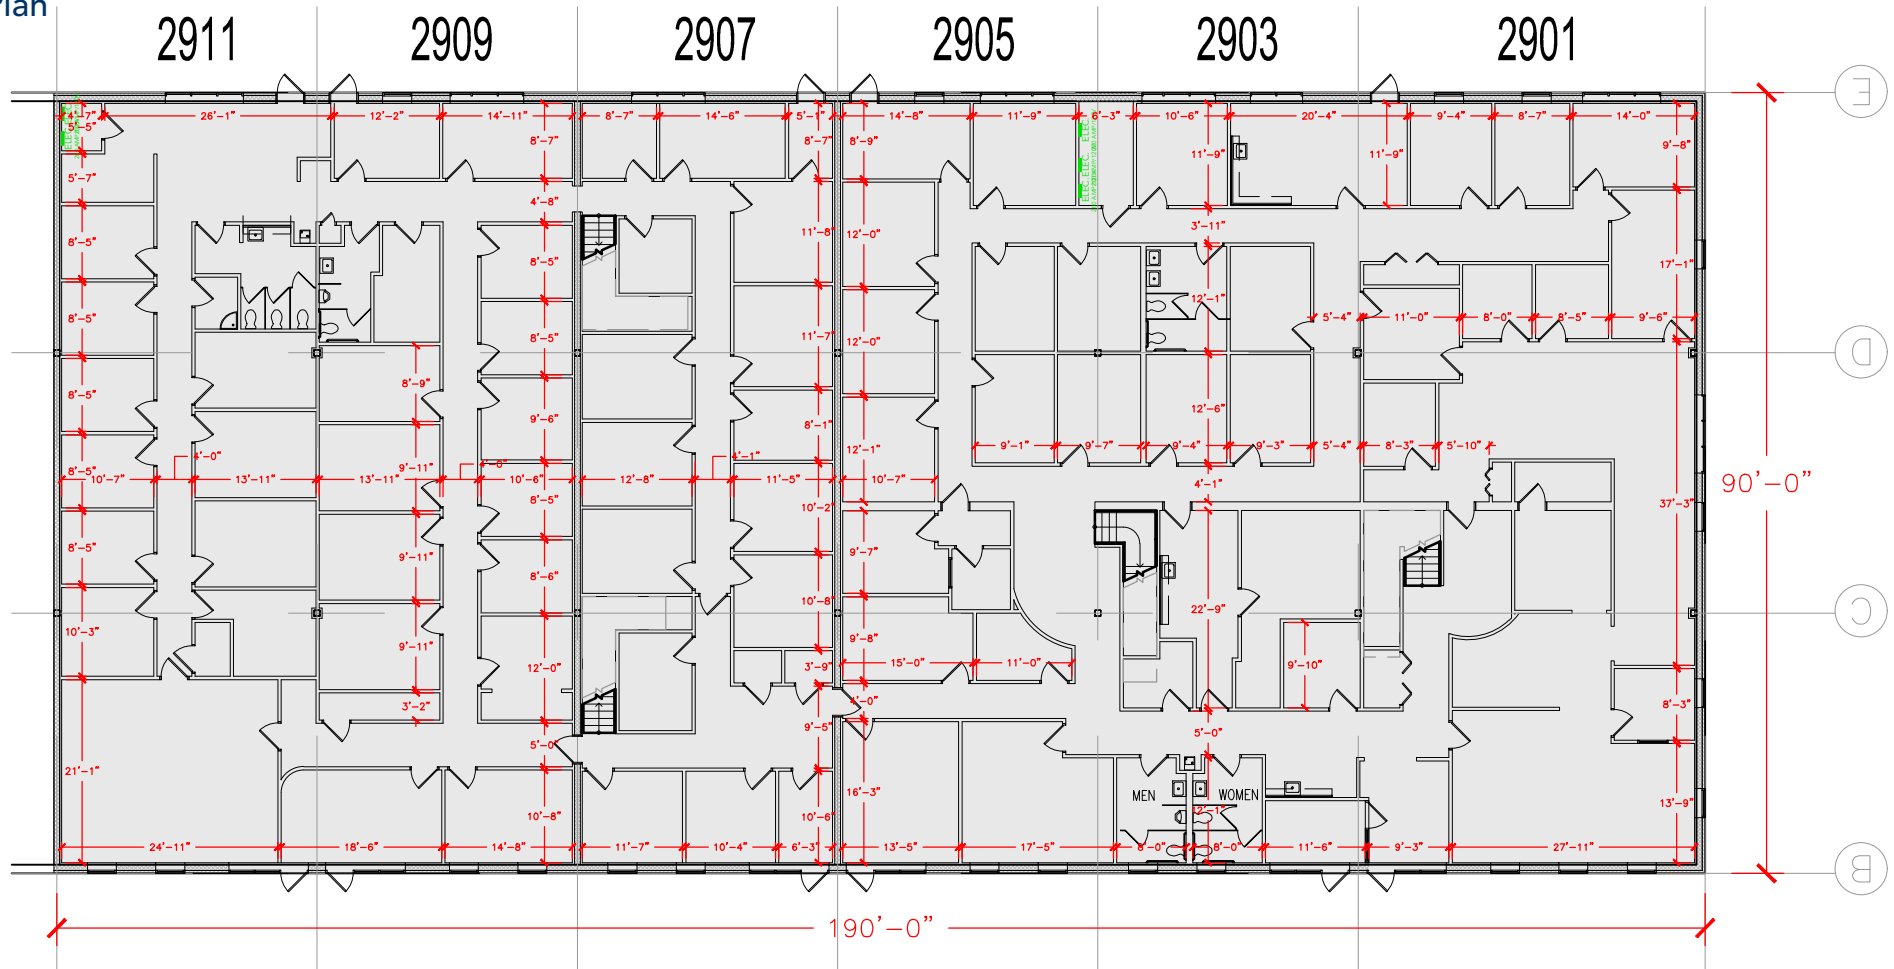

Floor Plan