


TOTAL SF AVAILABLE -17,100 SF


OFFICE - 0,000 SF

WAREHOUSE SF - 17,100 SF

[Click to access 3D model](#)

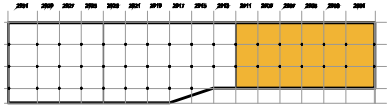

Key Plan

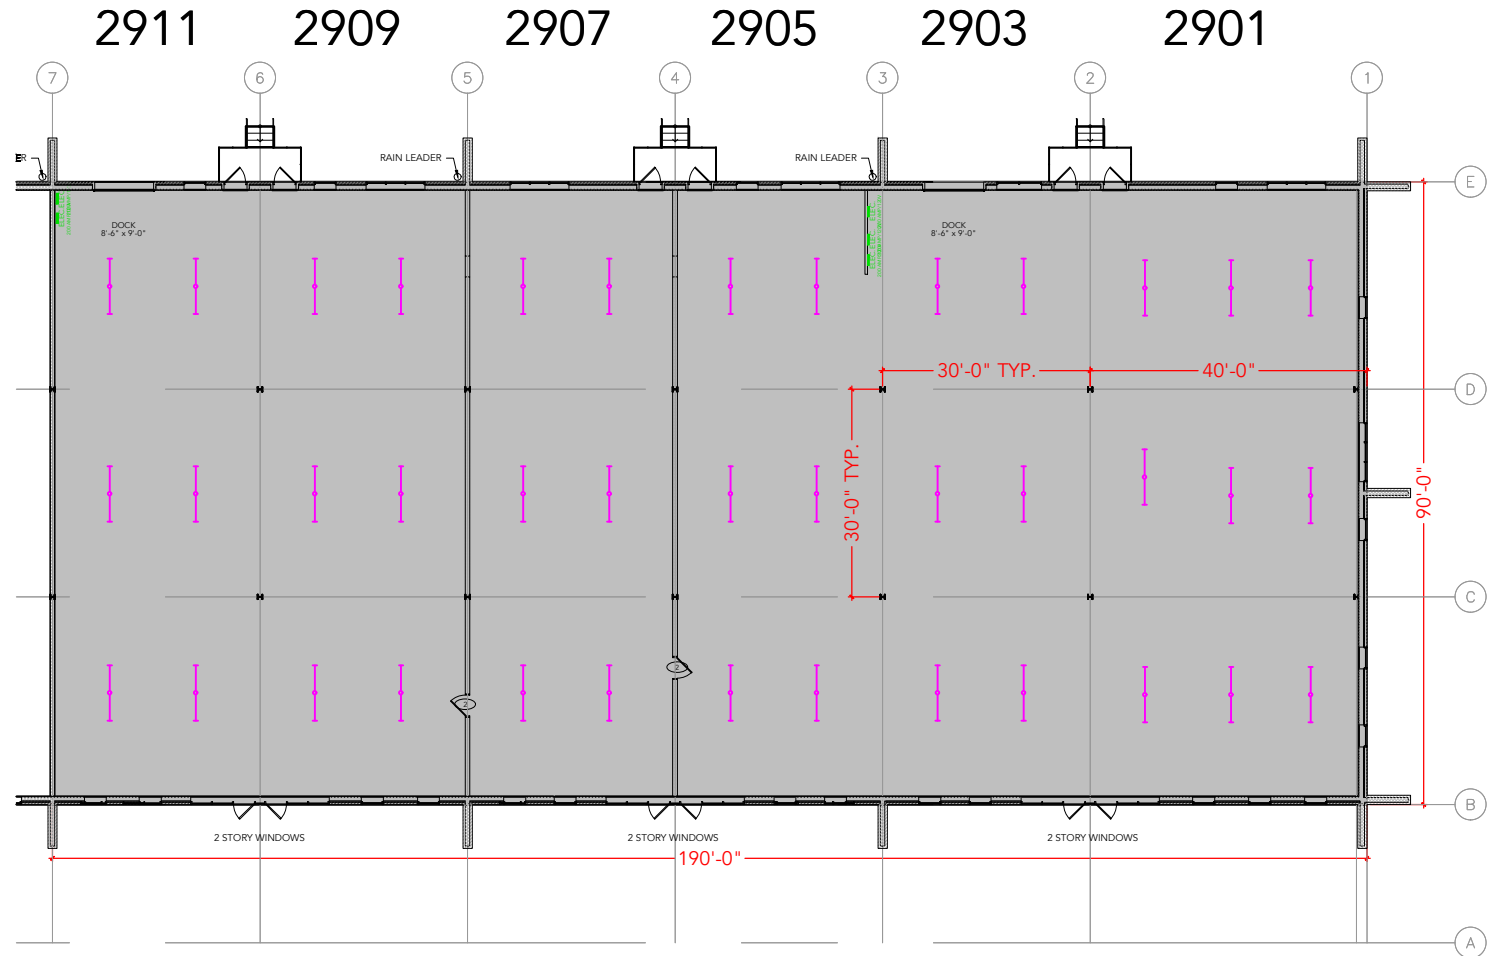

Floor Plan