


TOTAL SF AVAILABLE - 2,700 SF


OFFICE - 0,000 SF

WAREHOUSE SF - 2,700 SF

[Click to access CADD file](#)

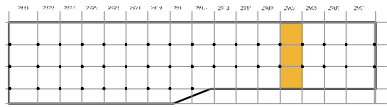

Key Plan

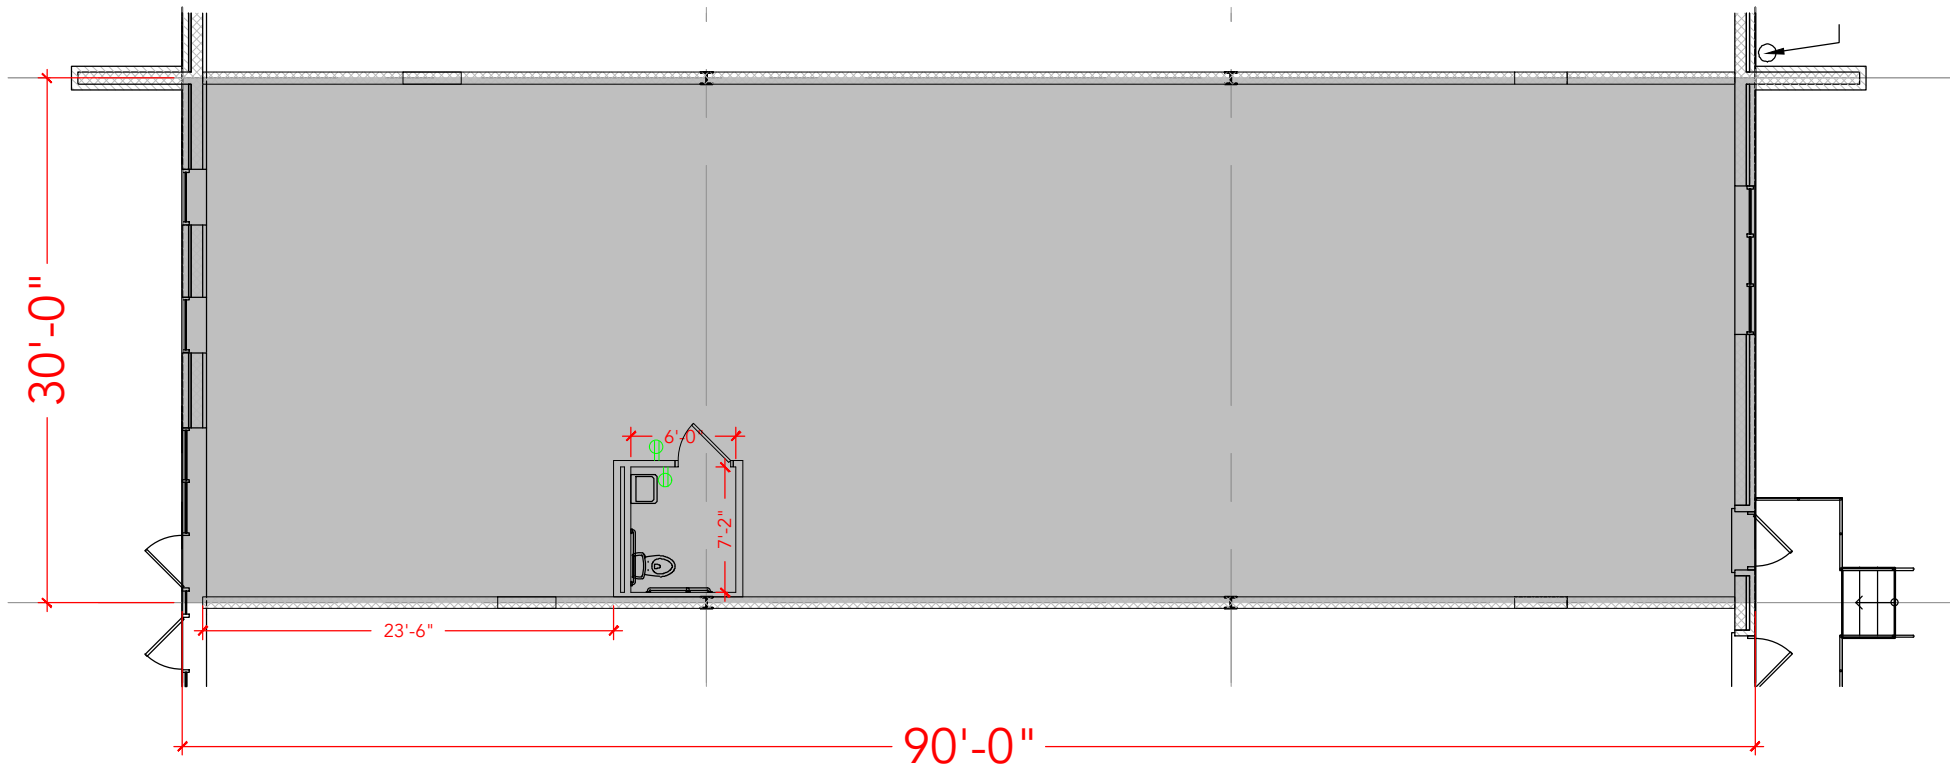

Floor Plan