


TOTAL SF AVAILABLE -2,700 SF


OFFICE - 0,000 SF

WAREHOUSE SF - 2,700 SF

[Click to access CADD file](#)

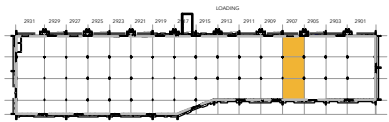

Key Plan

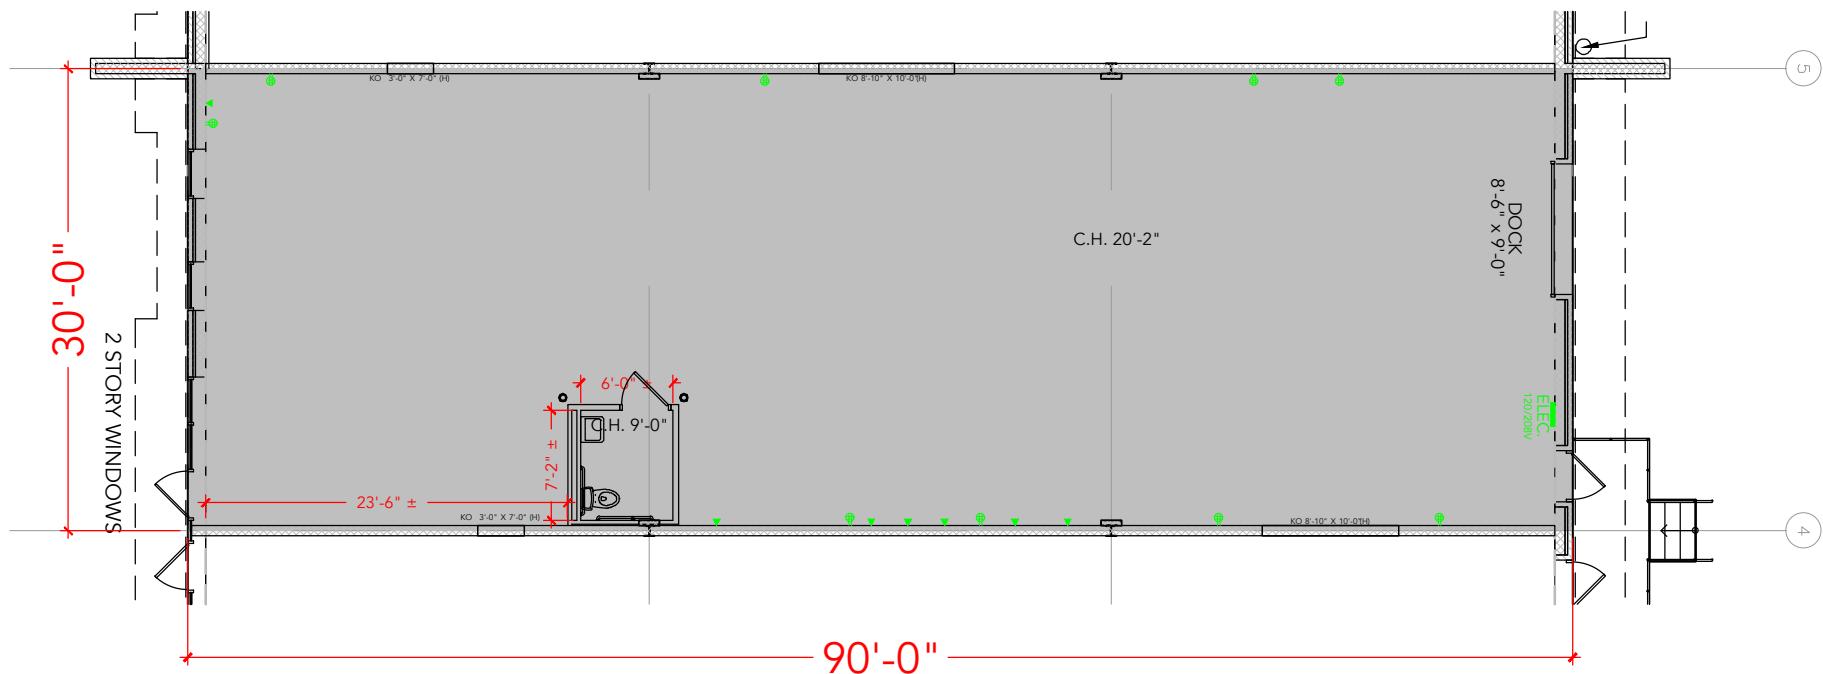

2907

Floor Plan