


TOTAL SF AVAILABLE -5,400 SF


OFFICE - 0,000 SF

WAREHOUSE SF - 5,400 SF

[Click to access 3D model](#)

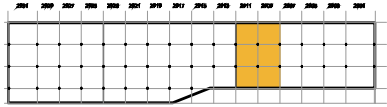

Key Plan

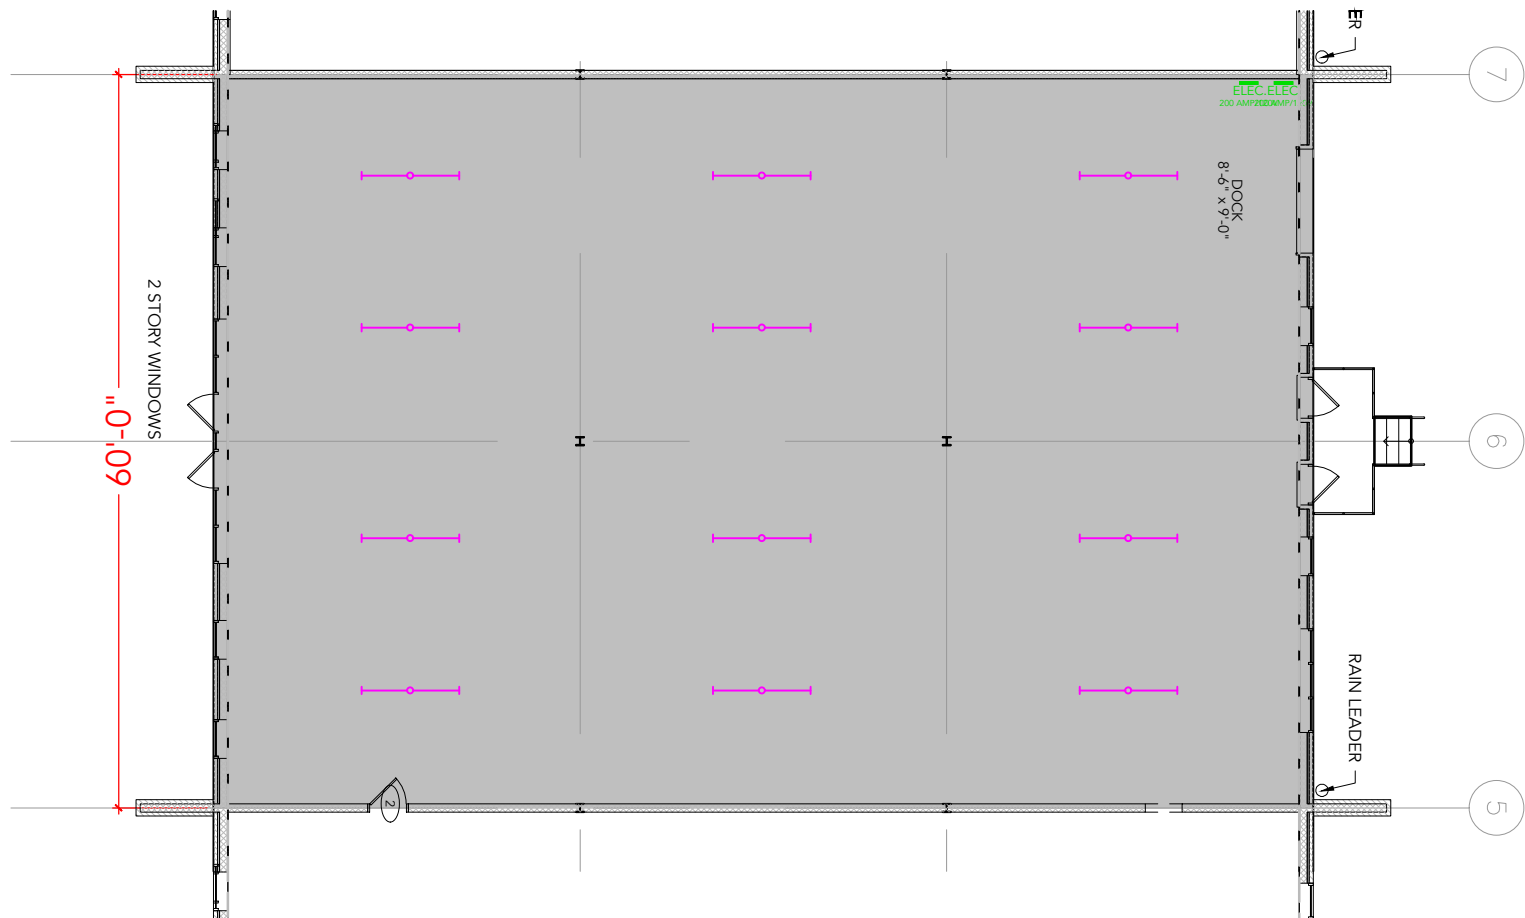

2911
2909

Floor Plan