


TOTAL SF AVAILABLE -14,300 SF


OFFICE - 14,032 SF

WAREHOUSE SF - 268 SF

[Click to access 3D model](#)

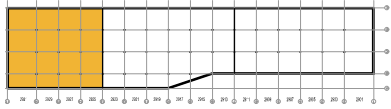

Key Plan

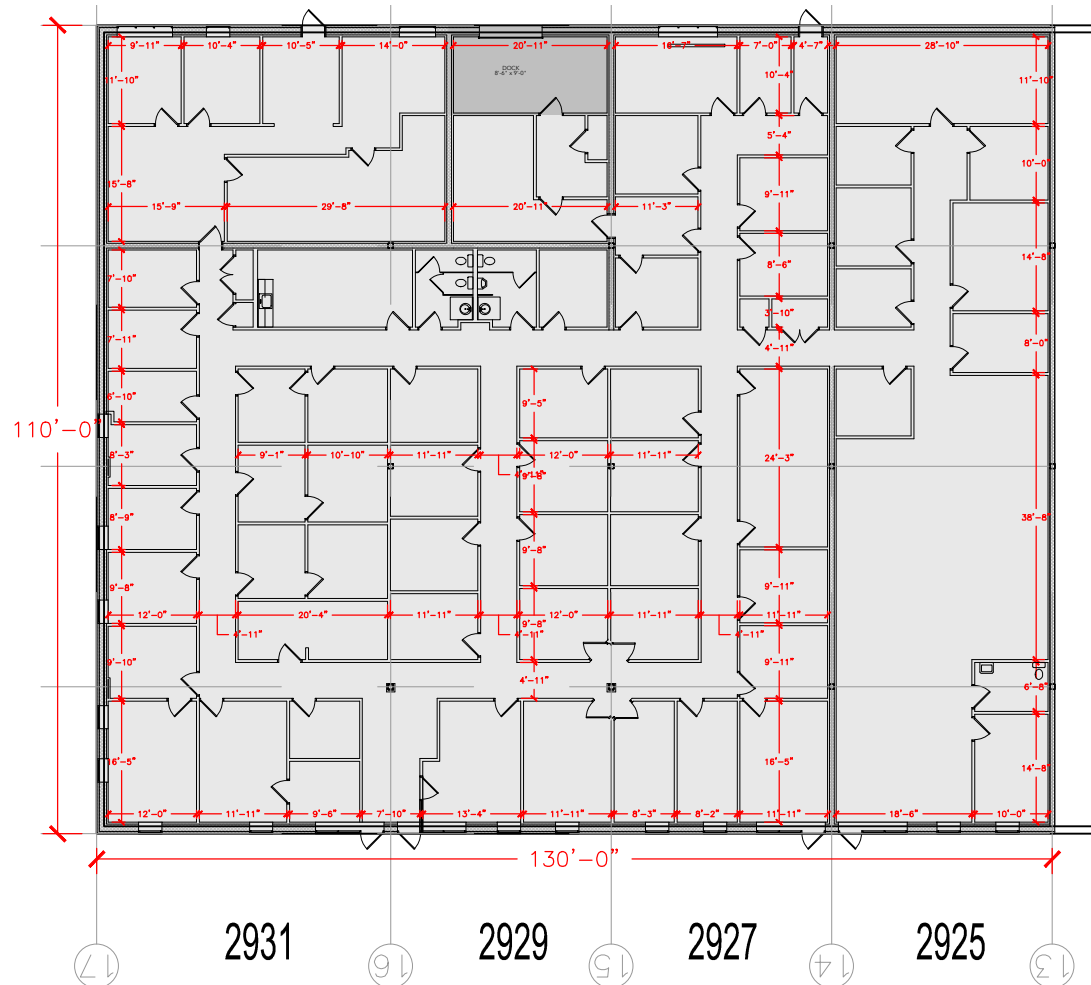

Floor Plan