


TOTAL SF AVAILABLE - 4,036 RSF

OFFICE - 4,036 RSF


WAREHOUSE - 0,000 SF

* INCLUDES % OF METER ROOM

[Click to access 3D model](#)

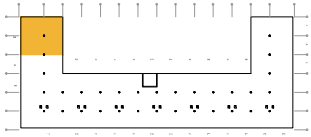

Key Plan

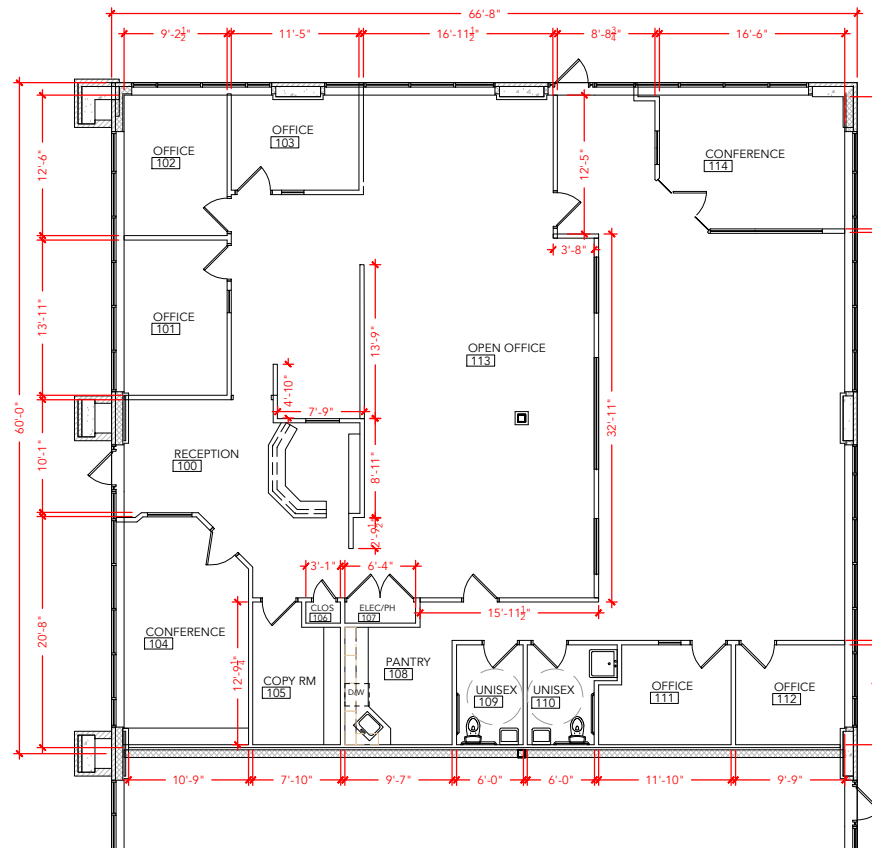

Floor Plan