

TOTAL SF AVAILABLE - 4,036 RSF


OFFICE - 4,036 RSF

WAREHOUSE - 0,000 SF

\* INCLUDES % OF METER ROOM

[Click to access 3D model](#)

## Key Plan

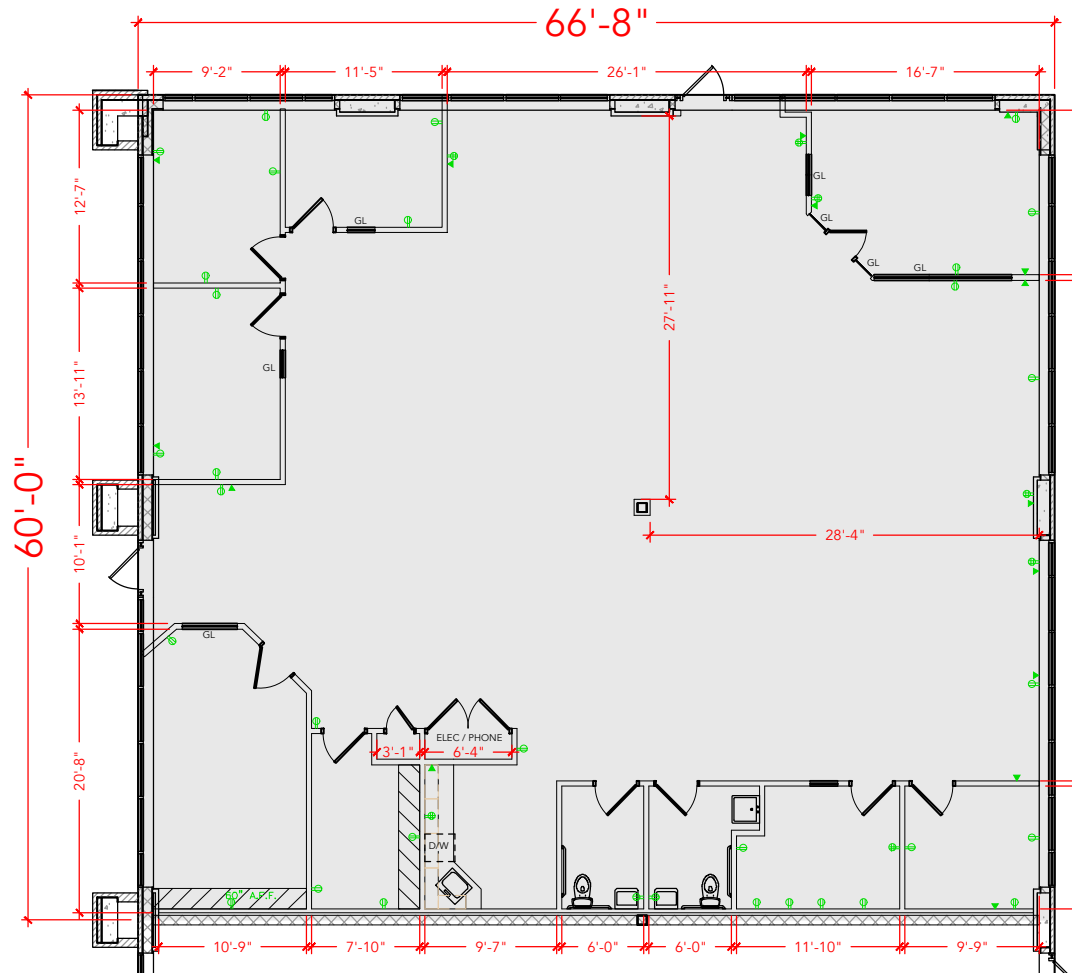

## Floor Plan