


**TOTAL SF AVAILABLE - 3,441 RSF**

**OFFICE - 3,441 RSF**

**WAREHOUSE - 0,000 SF**


\* INCLUDES % OF METER ROOM

[Click to access 3D model](#)

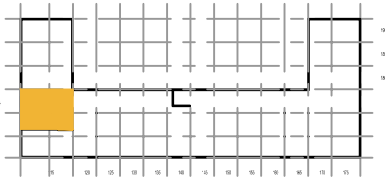

Key Plan

110

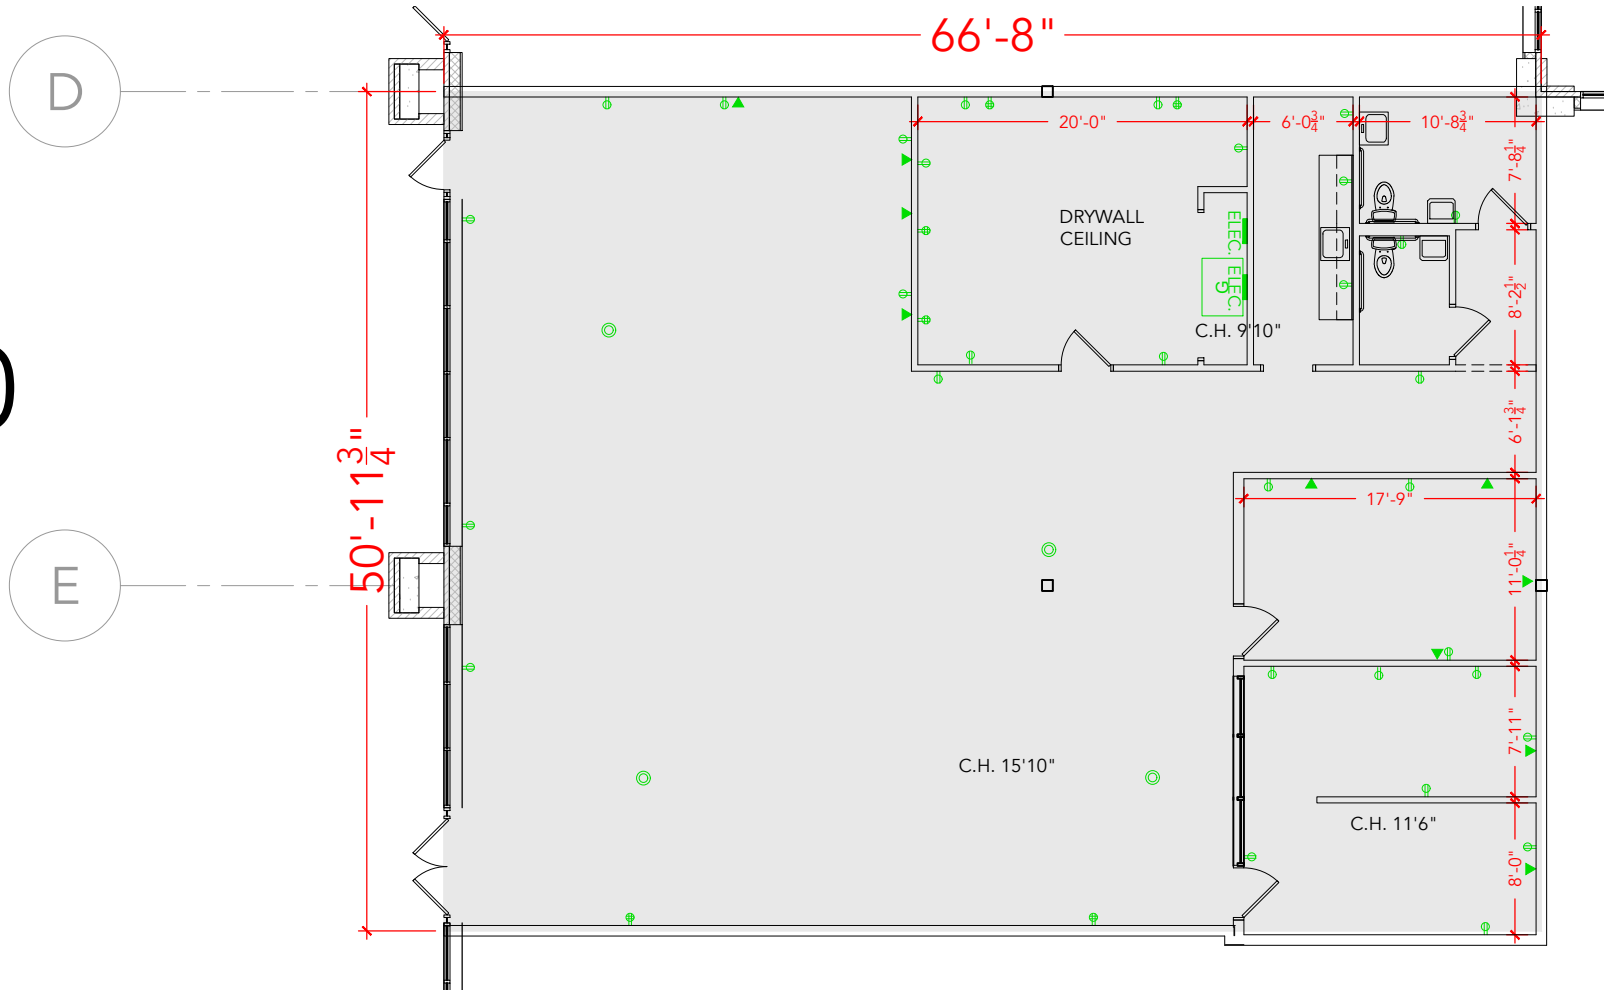

Floor Plan