


TOTAL SF AVAILABLE - 2,633 RSF

OFFICE - 2,633 RSF


WAREHOUSE SF - 0,000 SF

\* INCLUDES % OF METER TOOM

[Click to access 3D model](#)

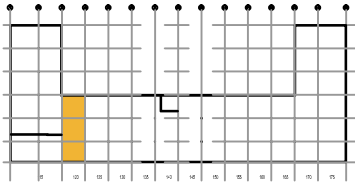

Key Plan

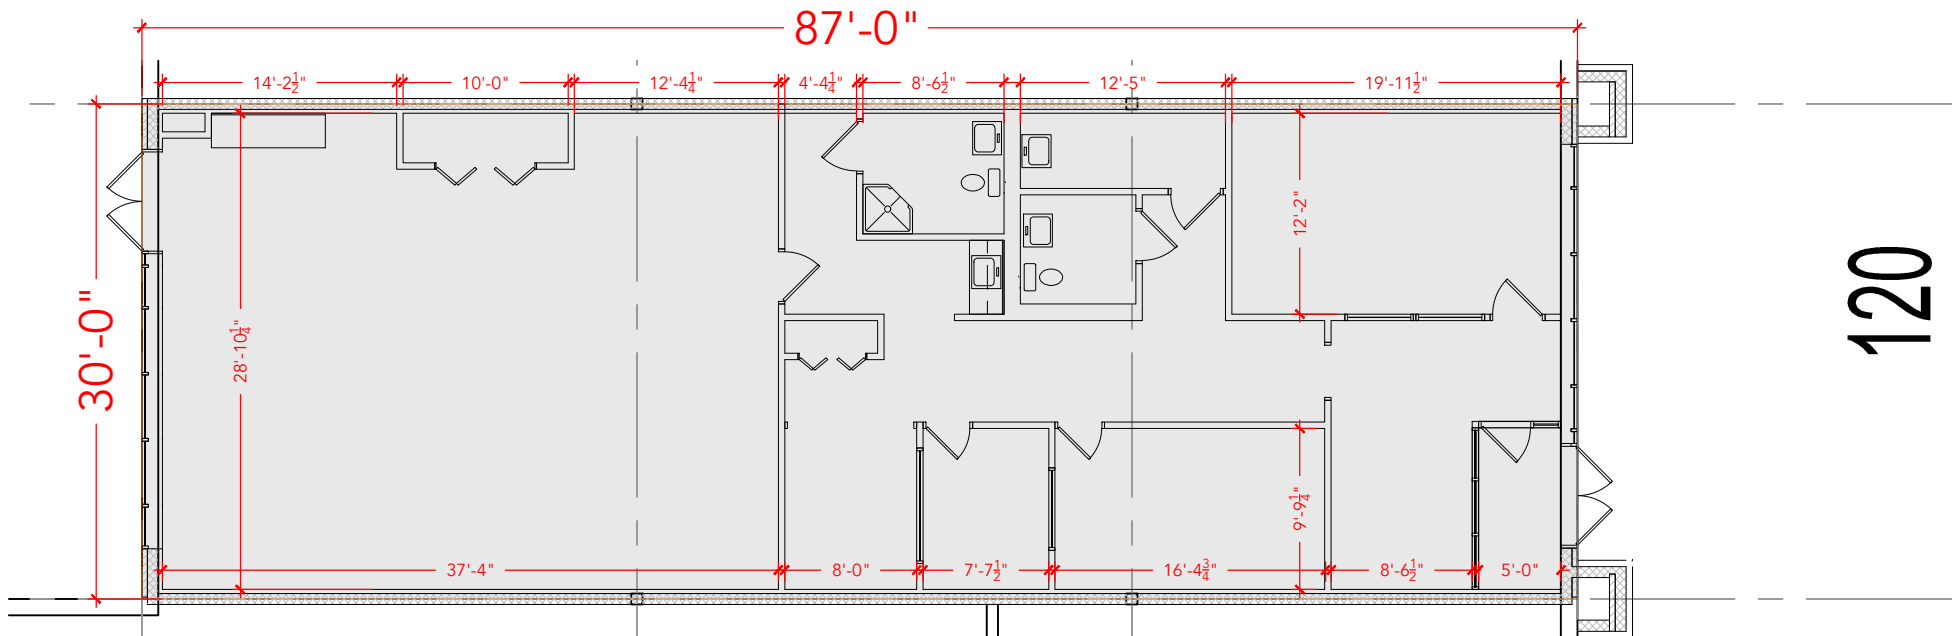

120

## Floor Plan