



LOUDOUN TECH CENTER 1

21240 RIDGETOP CIRCLE
SUITE 125-130
STERLING, VA 20166

Building Key Plan

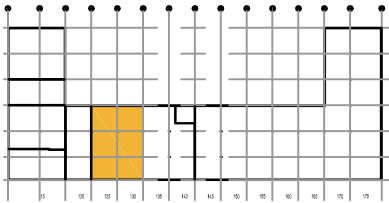

TOTAL SF AVAILABLE - 5,270 RSF

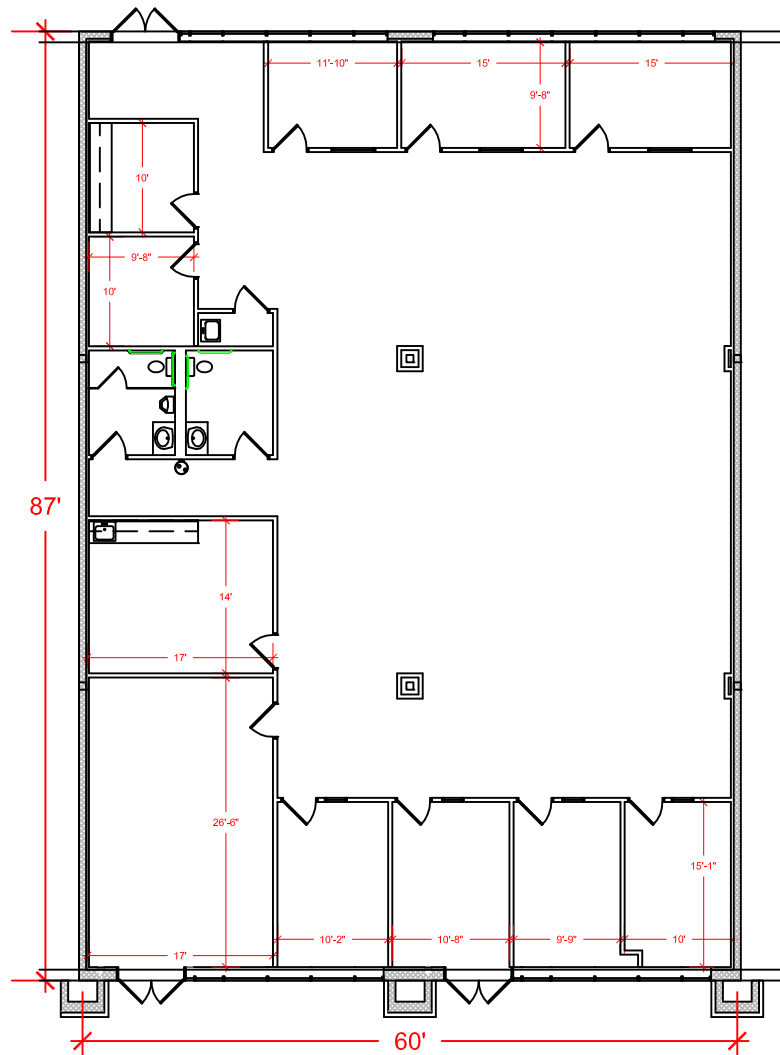

PLAN NOT TO SCALE - THIS IS NOT A CONSTRUCTION DOCUMENT

DRAWING #: LS1-125-130

ASBUILT DATE:

A Development of Merritt Properties

410.298.2600 / MerrittProperties.com