


TOTAL SF AVAILABLE - 4,804 RSF

OFFICE - 4,804 RSF

WAREHOUSE - 0,000 SF


\* INCLUDES % OF METER ROOM

[Click to access 3D model](#)

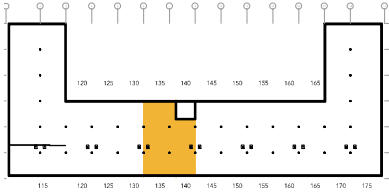

Key Plan

135  
140

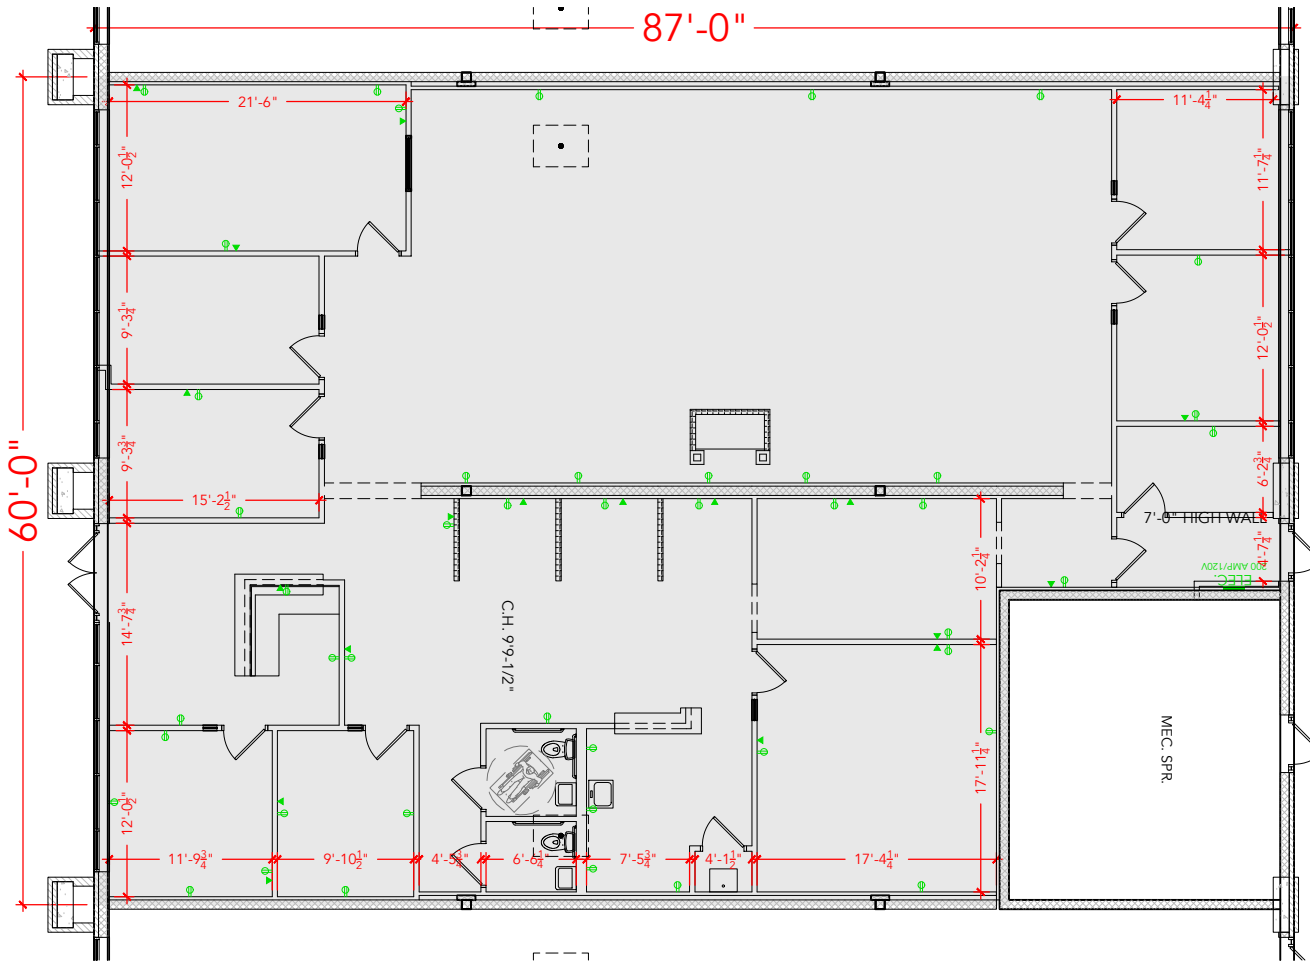

135  
140

Floor Plan