


**TOTAL SF AVAILABLE - 4,804 RSF**

**OFFICE - 4,804 RSF**


**WAREHOUSE - 0,000 SF**

\* INCLUDES %OF METER ROOM

[Click to access 3D model](#)

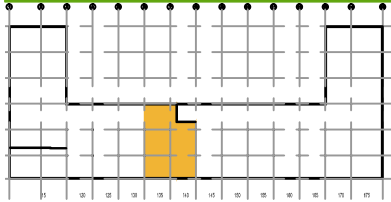

Key Plan

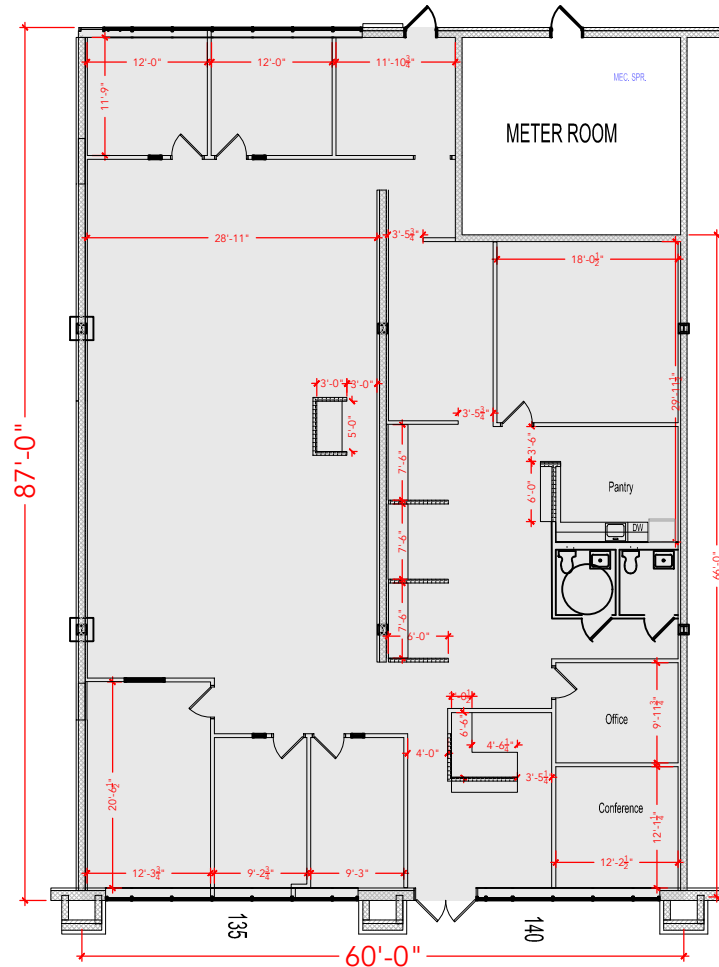

Floor Plan