

TOTAL SF AVAILABLE - 4,960 RSF

OFFICE - 4,960 RSF

WAREHOUSE - 0,000 SF


* INCLUDES % OF METER ROOM

[Click to access 3D model](#)

LOADING

100	110	120	130	140	150	160	170	180	190
■	■		■						

Key Plan

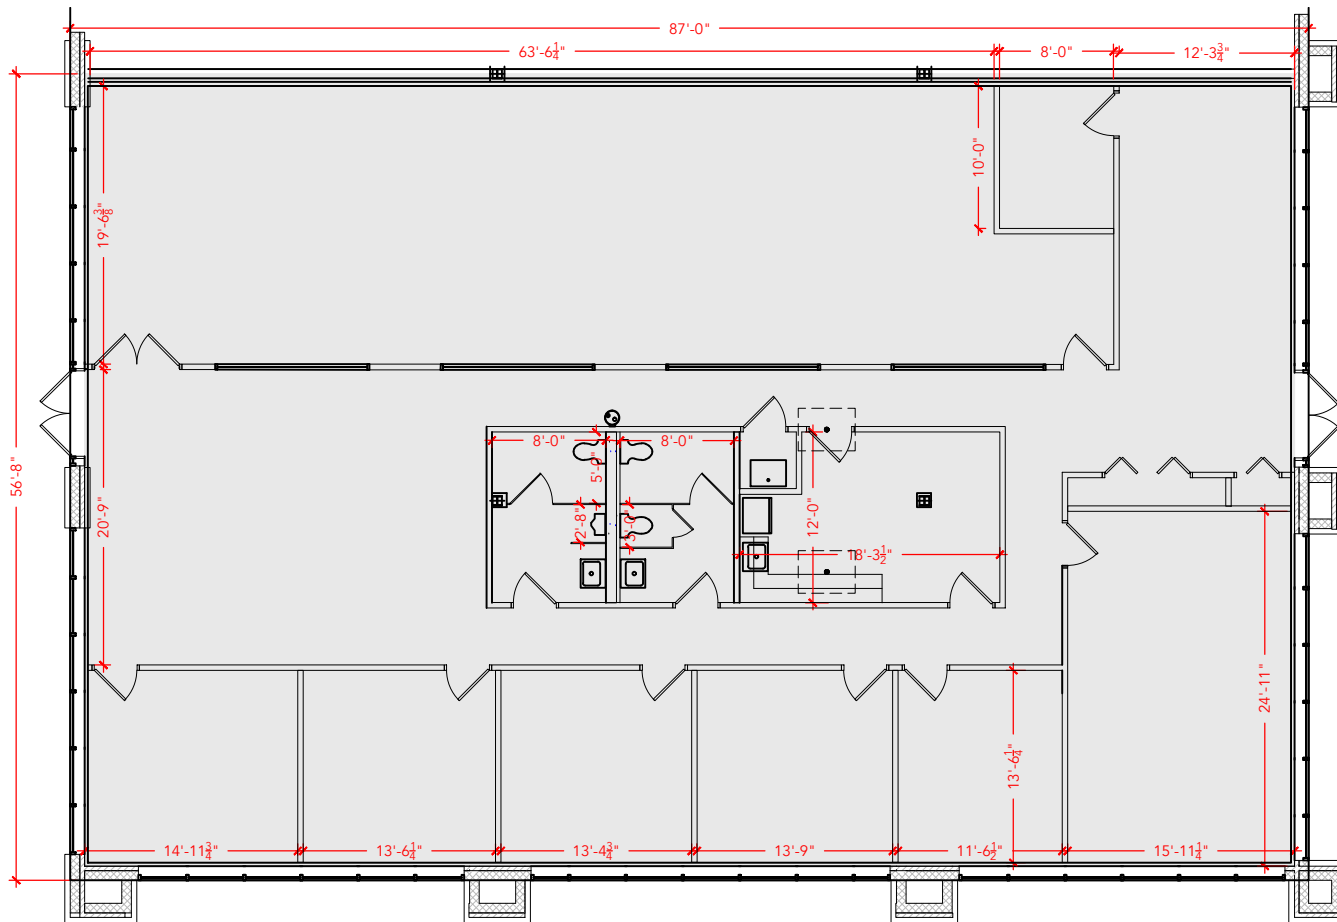

Floor Plan