

TOTAL SF AVAILABLE - 2,635 RSF


OFFICE - 0,000 SF

WAREHOUSE - 0,000 SF

* INCLUDES % OF METER ROOM

[Click to access 3D model](#)

Key Plan

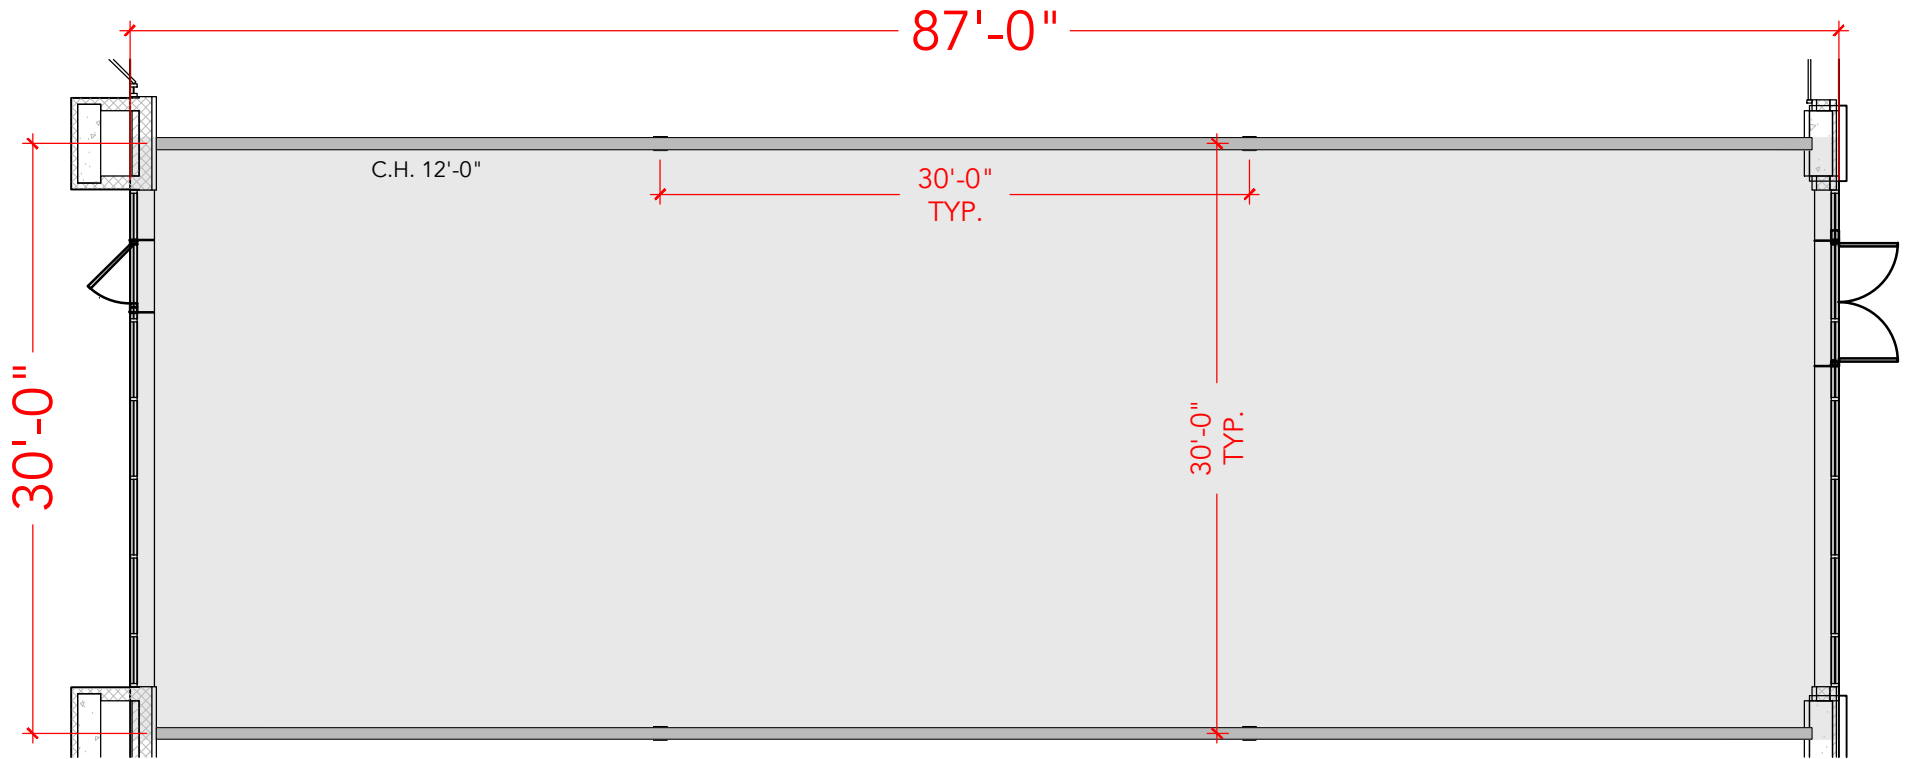

Floor Plan