


TOTAL SF AVAILABLE - 2,635 RSF

OFFICE - 0,000 SF


WAREHOUSE - 2,635 RSF

* INCLUDED % OF METER ROOM

[Click to access 3D model](#)

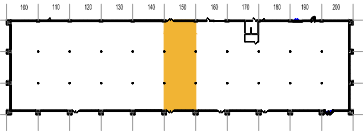

Key Plan

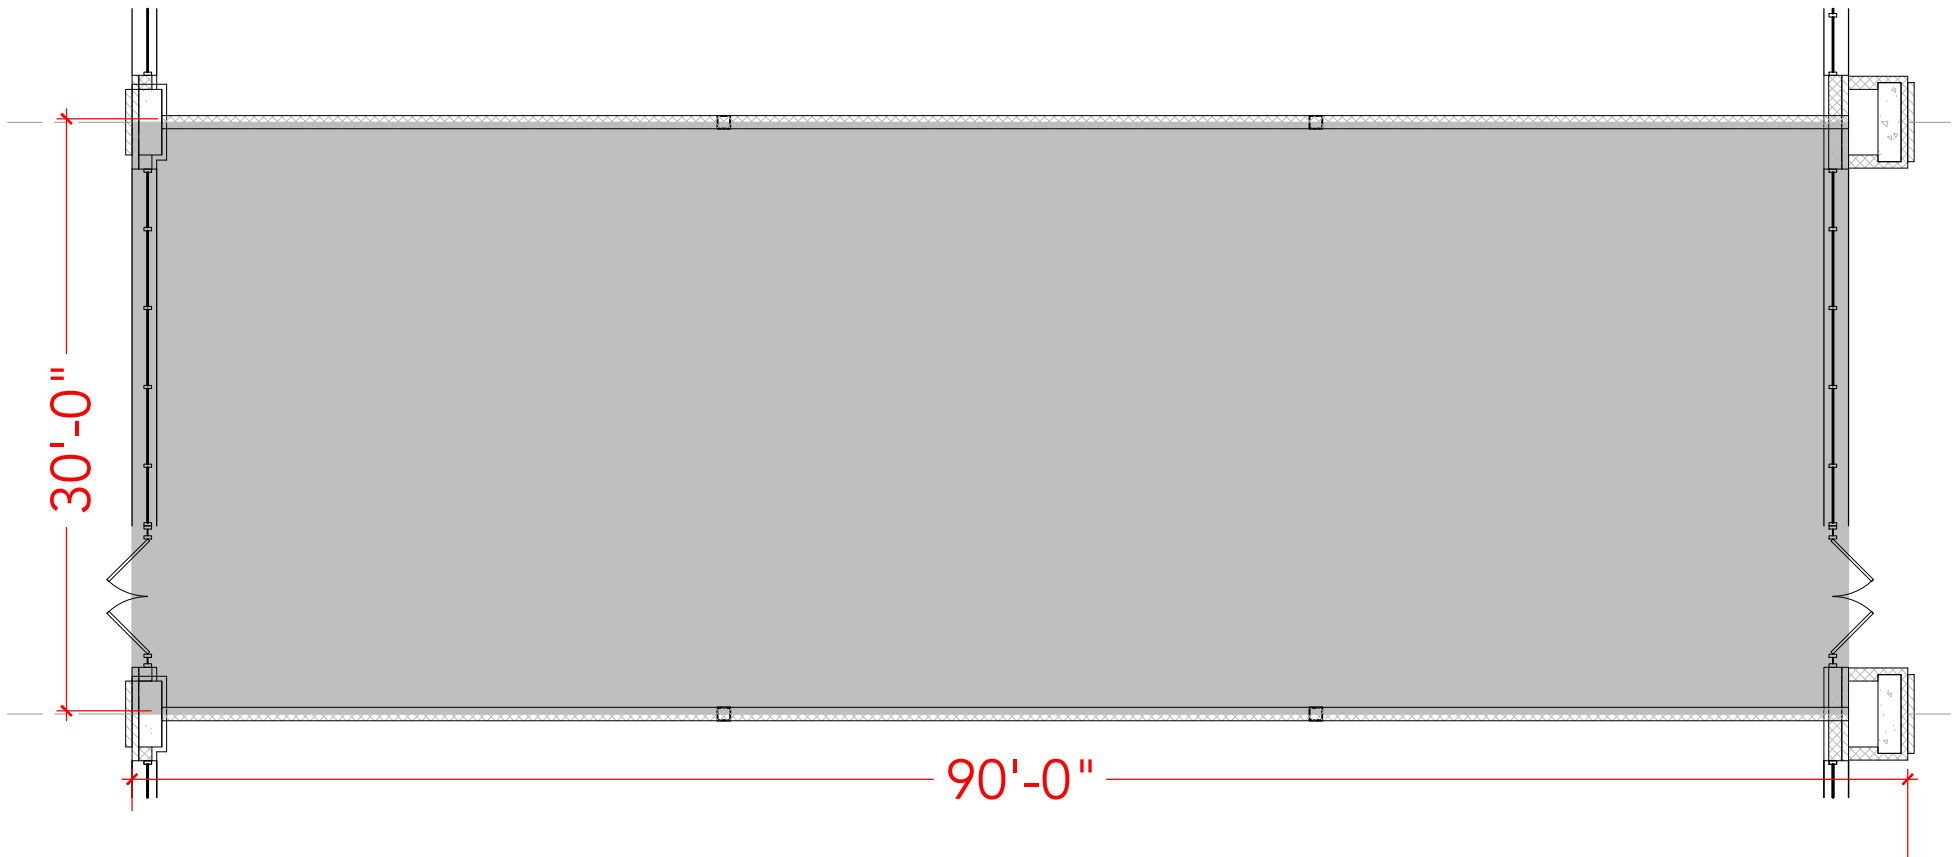

Floor Plan