


TOTAL SF AVAILABLE - 4,999 RSF


OFFICE - 0,000 SF

WAREHOUSE SF - 4,999 RSF

[Click to access 3D model](#)

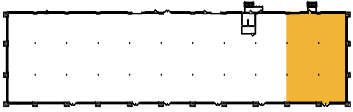

Key Plan

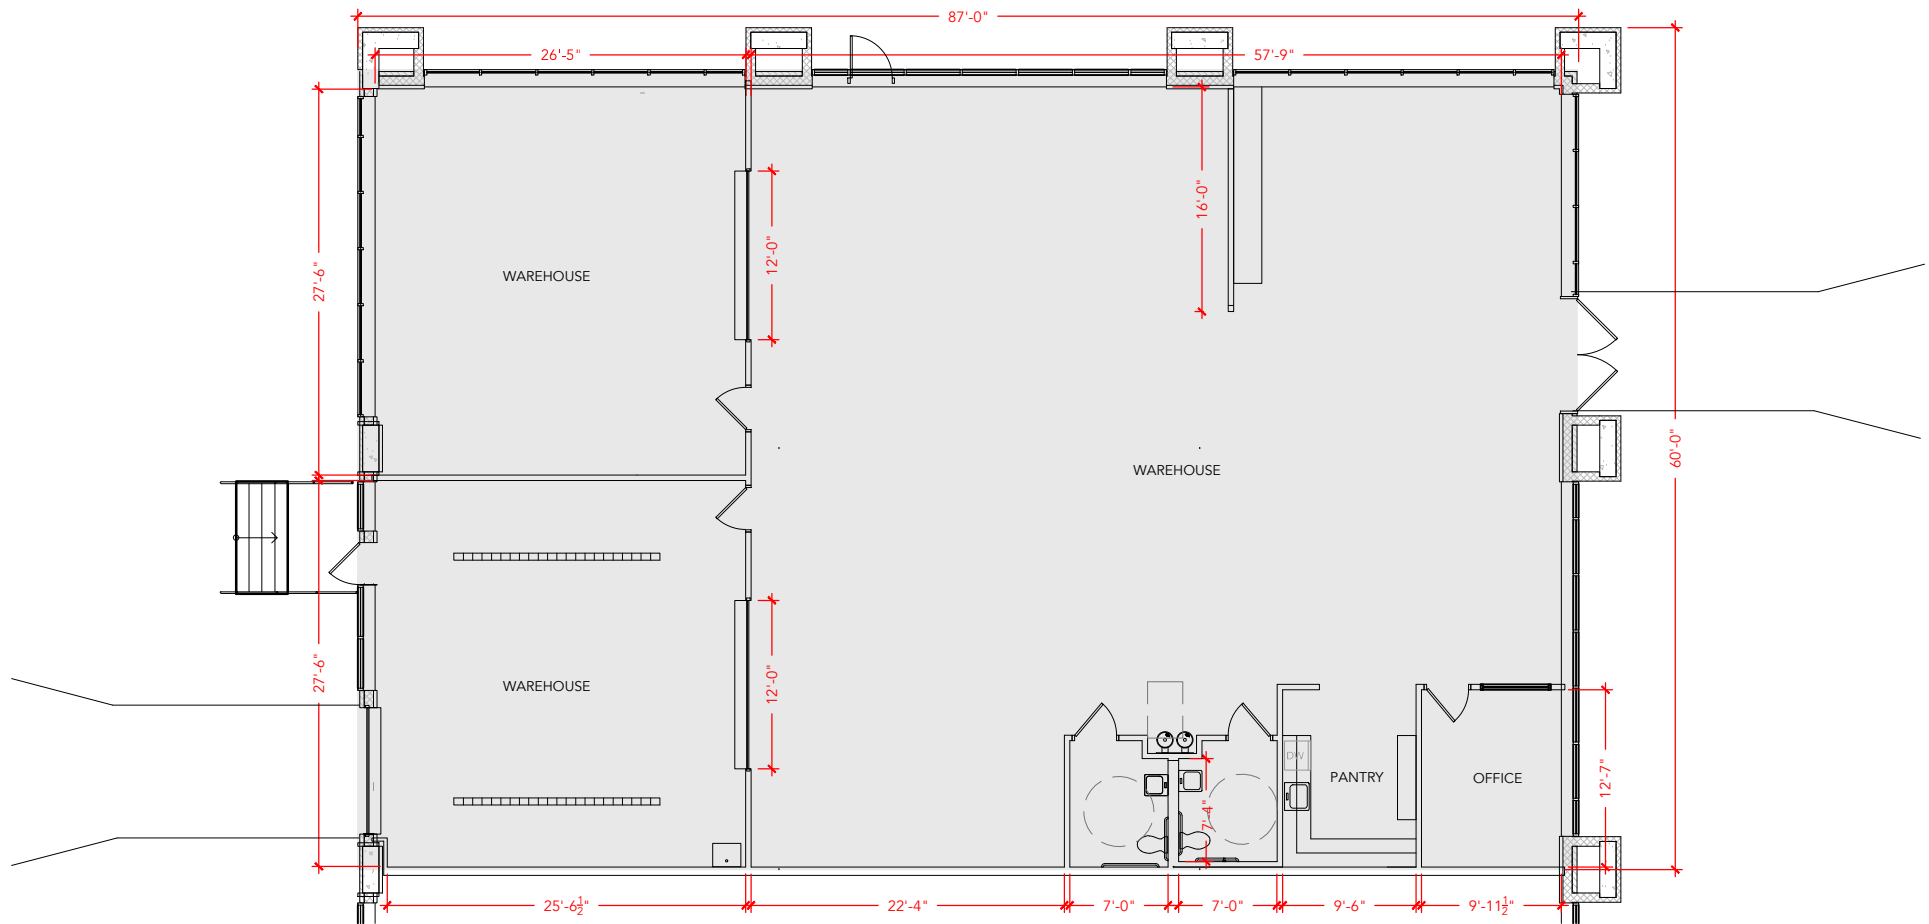

Floor Plan