



# Loudoun Tech Center

45945 Center Oak Plaza  
Suites 190  
Sterling, VA 20166

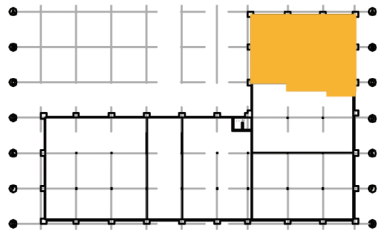

Building Key Plan

Total SF Office Available  
5,465 RSF

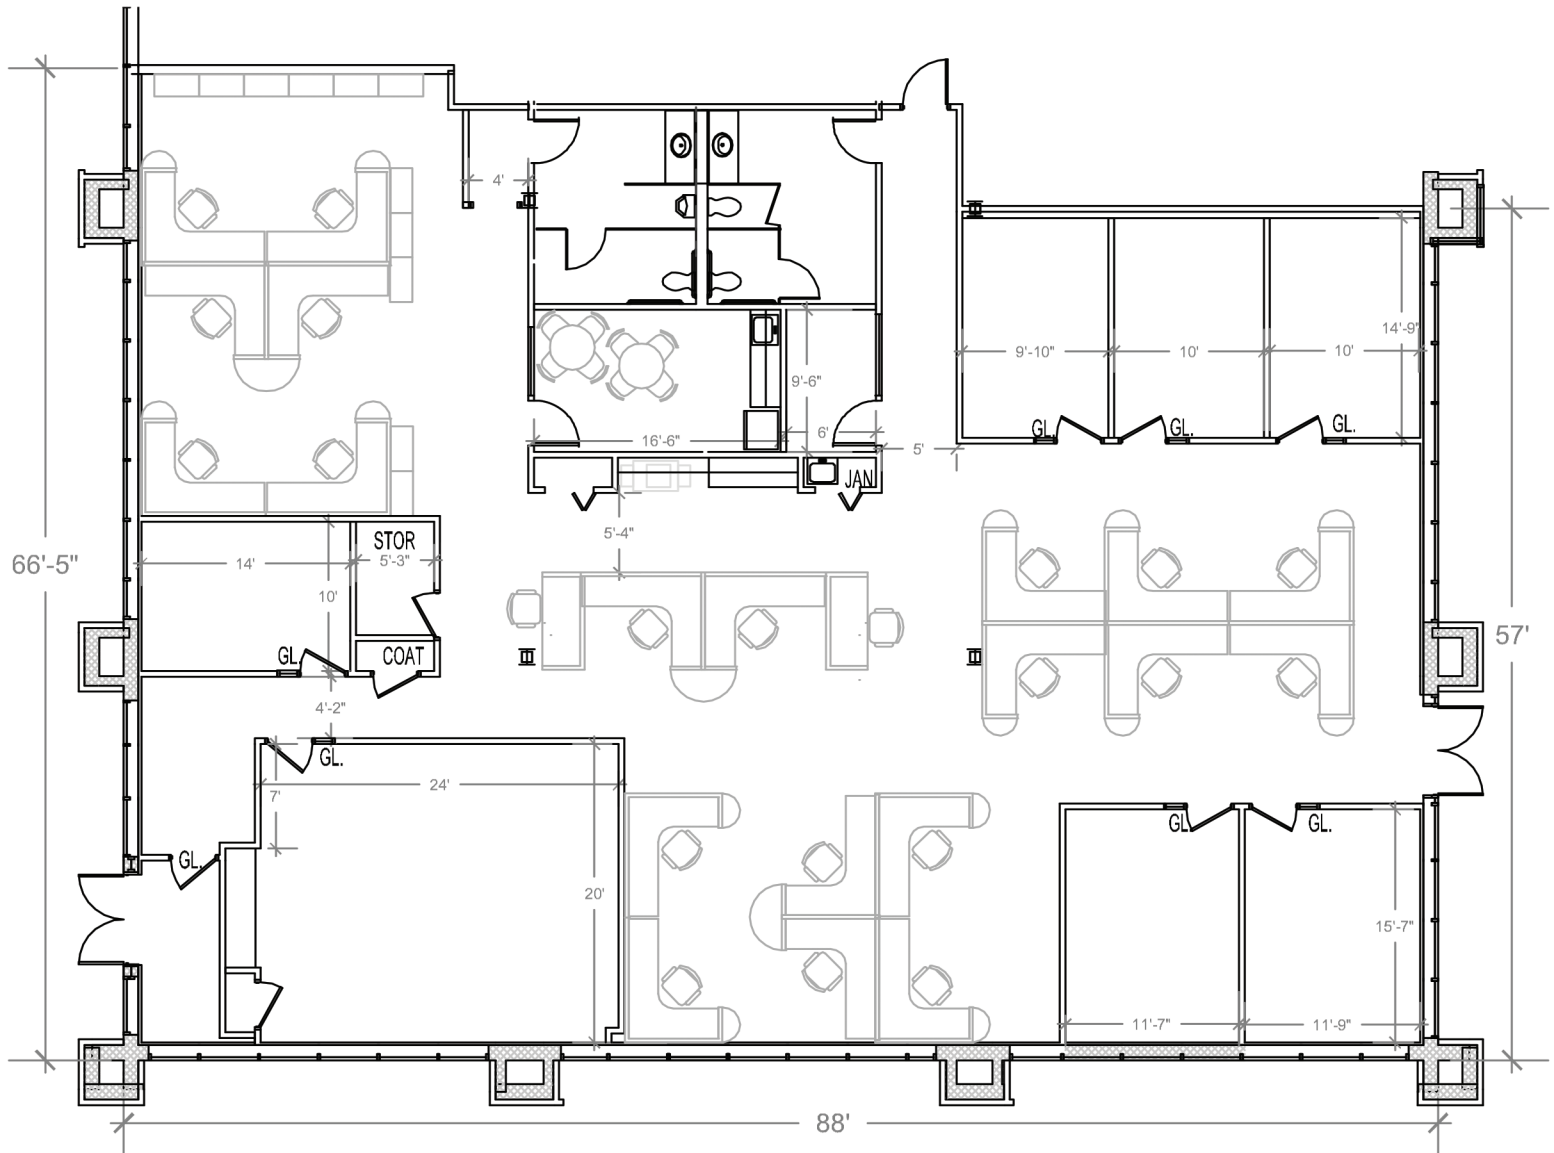

Plan not to scale - this is not a construction document.