


TOTAL SF AVAILABLE - 2,657 RSF


OFFICE - 2,657 SF

WAREHOUSE - 0,000 SF

[Click to access 3D model](#)

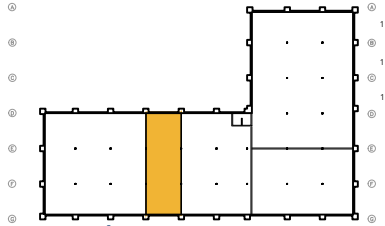

Key Plan

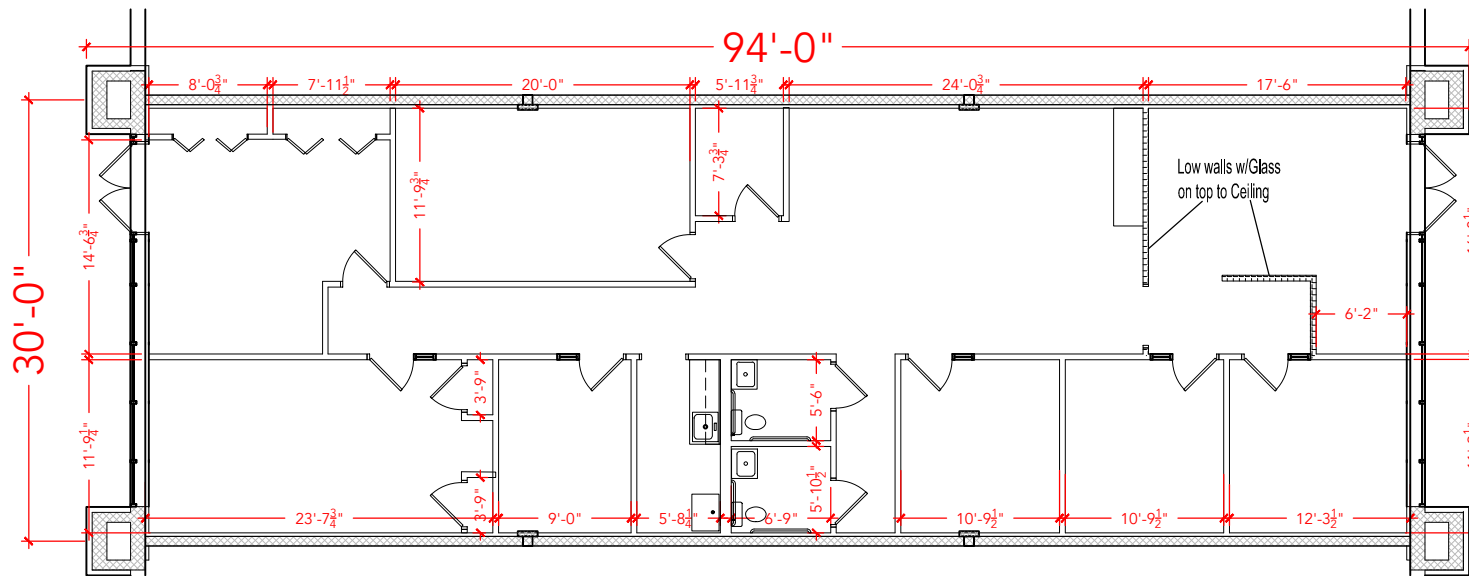

## Floor Plan