



TOTAL SF AVAILABLE - 15,636 RSF

OFFICE - 15,636 RSF

WAREHOUSE - 0,000 SF

* INCLUDES % OF METER ROOM

[Click to access 3D model](#)

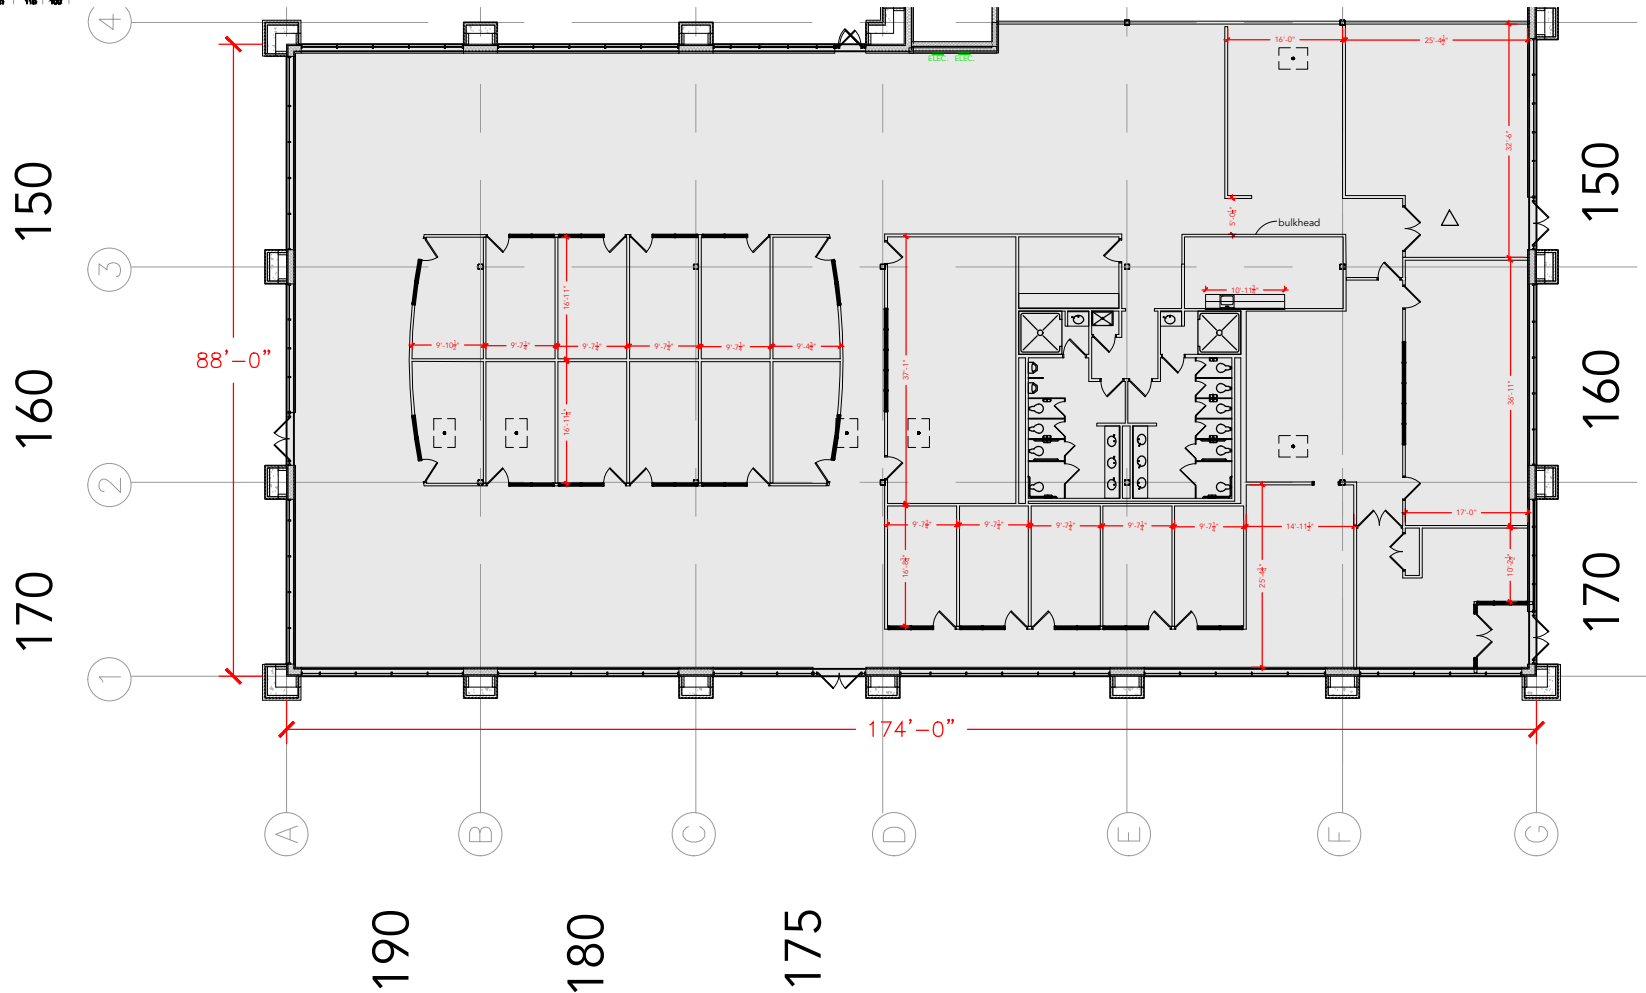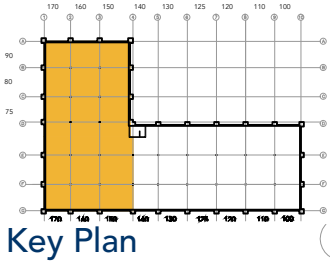

Floor Plan