


TOTAL SF AVAILABLE -14,099 RSF

OFFICE - 14,099 RSF

WAREHOUSE - 0,000 RSF

* % OF METER ROOM INCLUDED

[Click to access 3D model](#)

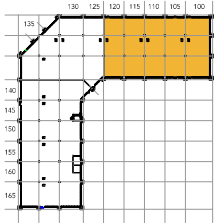

Key Plan



Floor Plan