


Key Plan

TOTAL SF AVAILABLE - 24,006 RSF

OFFICE - 14,099 SF

WAREHOUSE - 9,907 SF

[Click to access 3D model](#)

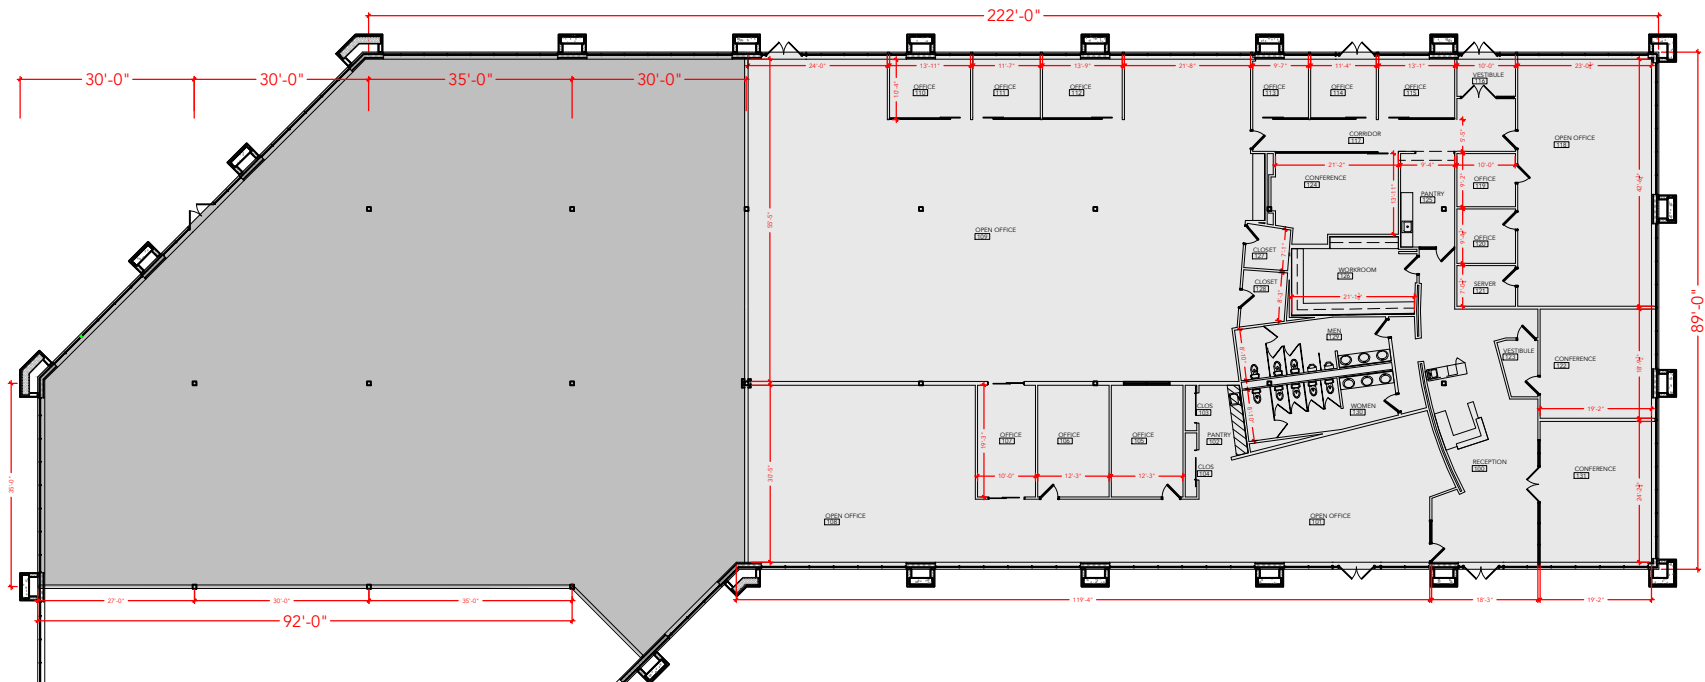

Floor Plan