


TOTAL SF AVAILABLE - 26,370 RSF


OFFICE - 0 RSF

WAREHOUSE - 26,370 SF

[Click to access 3D model](#)

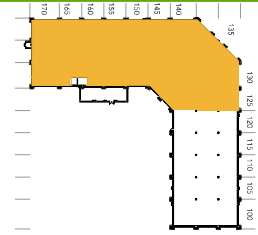

Key Plan

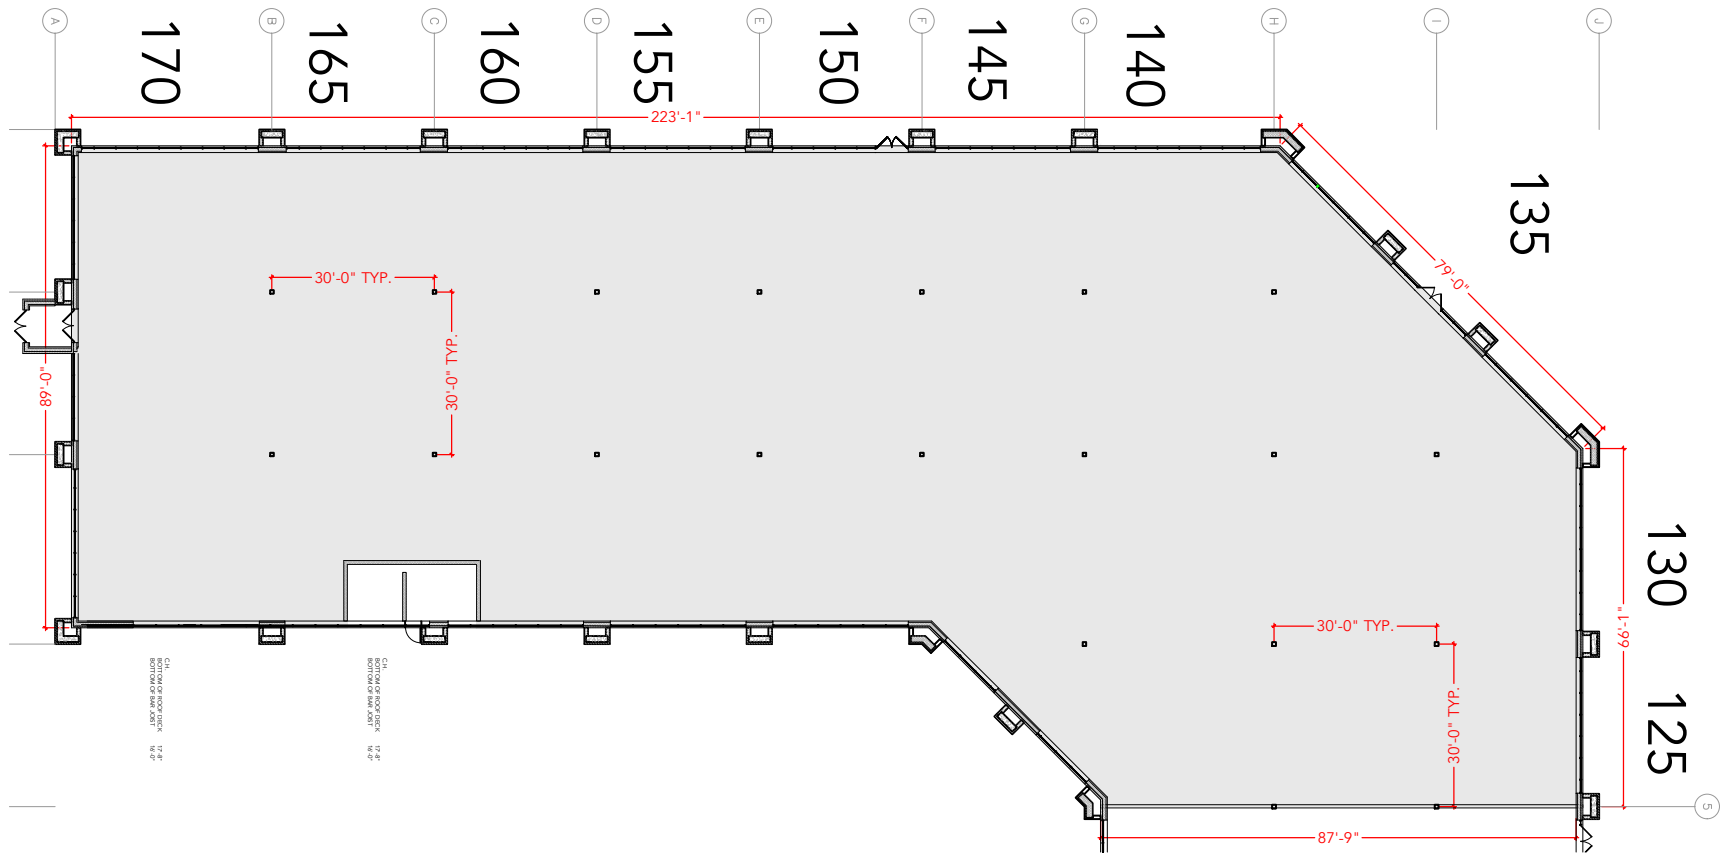

Floor Plan