


TOTAL SF AVAILABLE -5,381 RSF

OFFICE - 5,381 RSF


WAREHOUSE SF - 0,000 SF

* % OF METER ROOM INCLUDED

[Click to access 3D model](#)

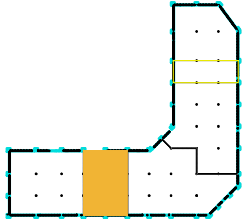

Key Plan

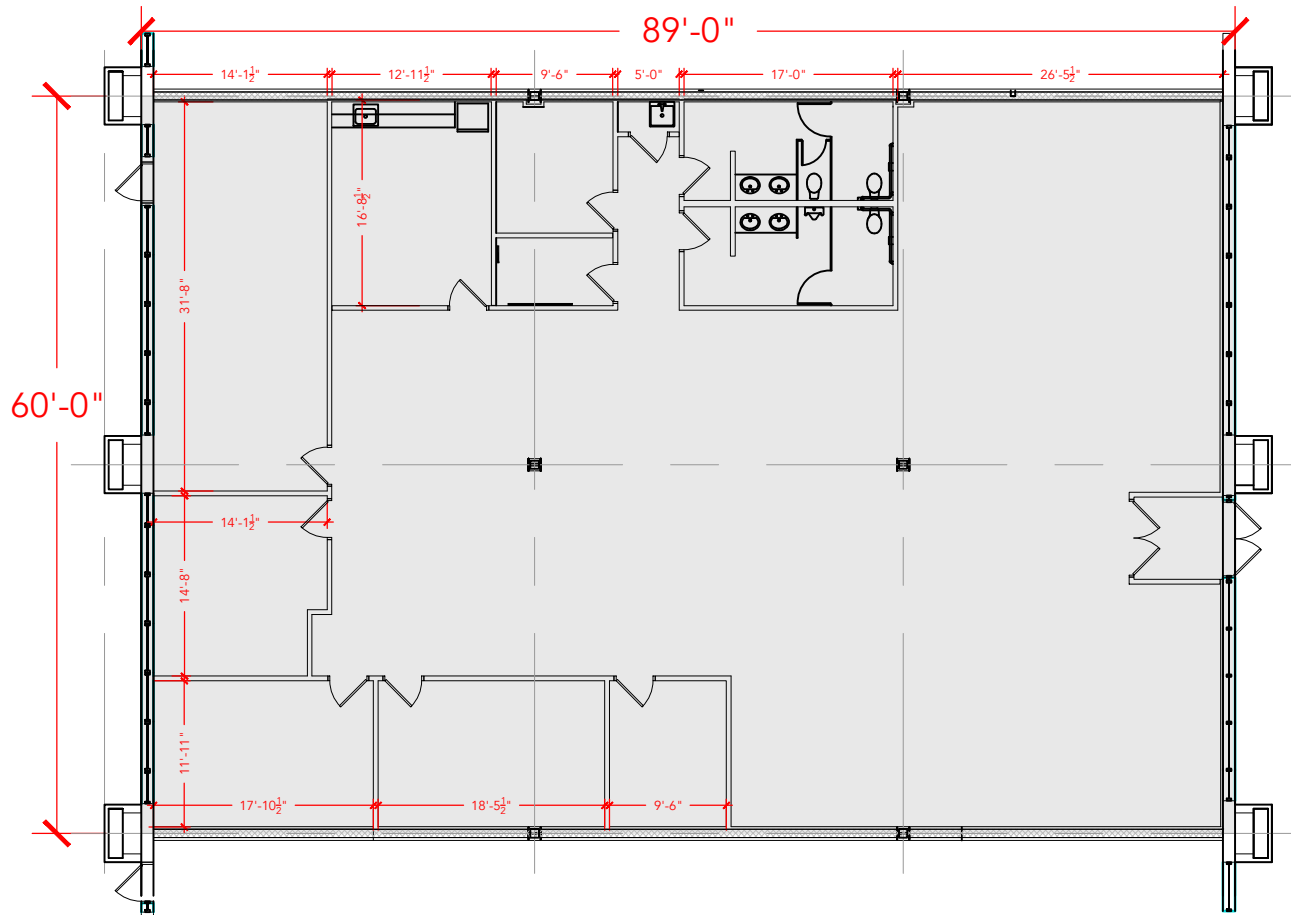

Floor Plan