


TOTAL SF AVAILABLE - 5,381 RSF


OFFICE - 5,381 RSF

WAREHOUSE SF - 0,000 SF

[Click to access 3D model](#)

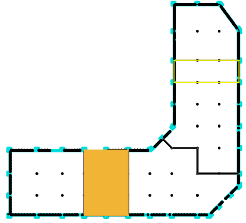

Key Plan

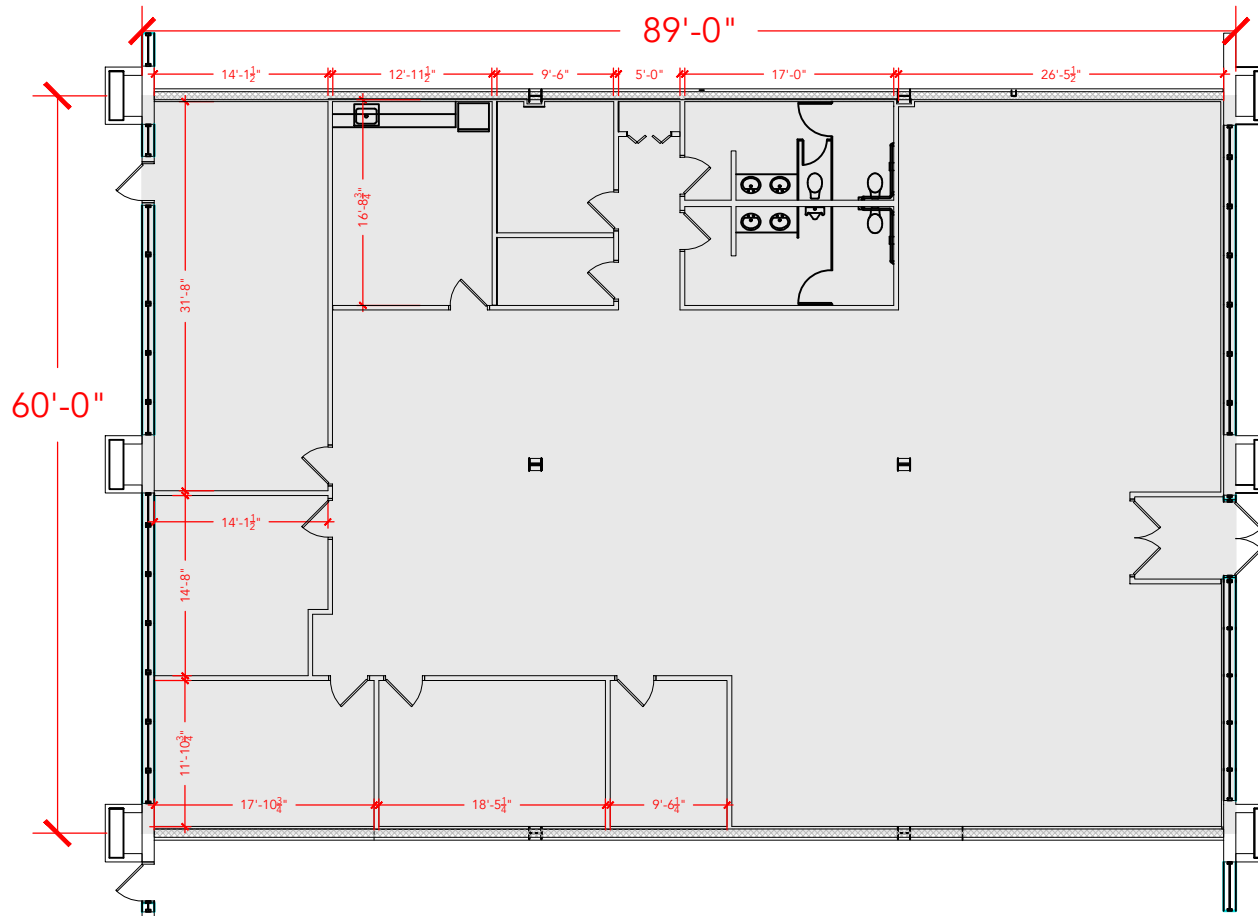

Floor Plan