


TOTAL SF AVAILABLE - 60,178 SF

1ST FLOOR - 29,078 SF

2ND FLOOR - 31,100 SF

[Click to access 3D model](#)

Key Plan

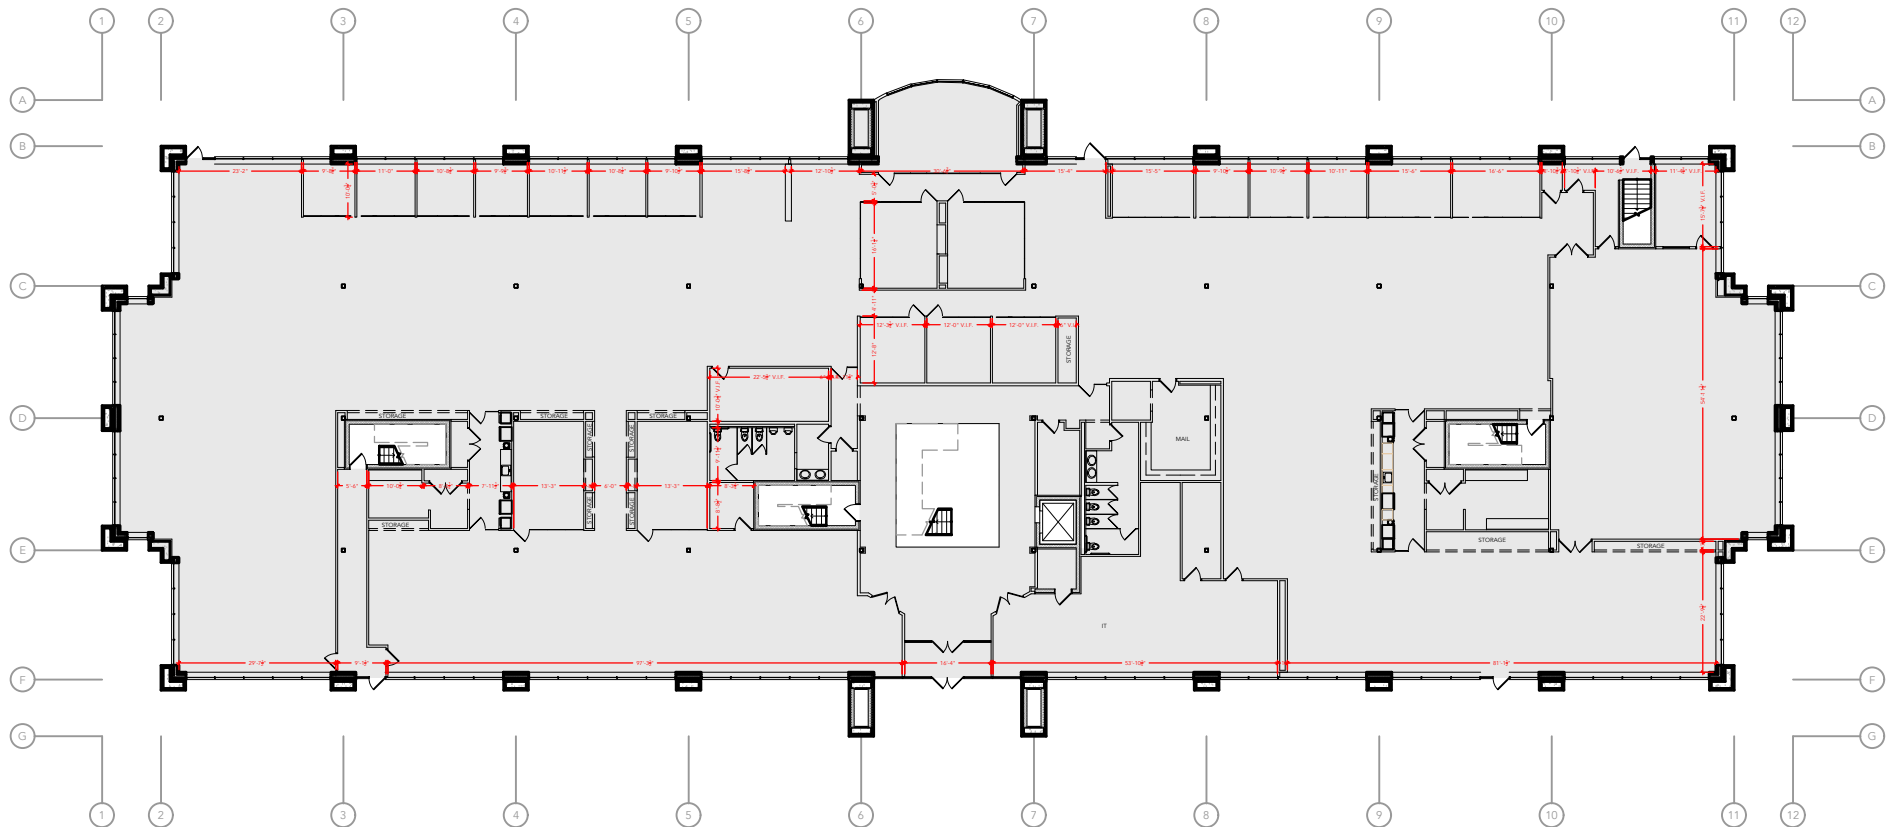

Floor Plan