


TOTAL SF AVAILABLE - 19,403 RSF



[Click to access 3D model](#)

Key Plan

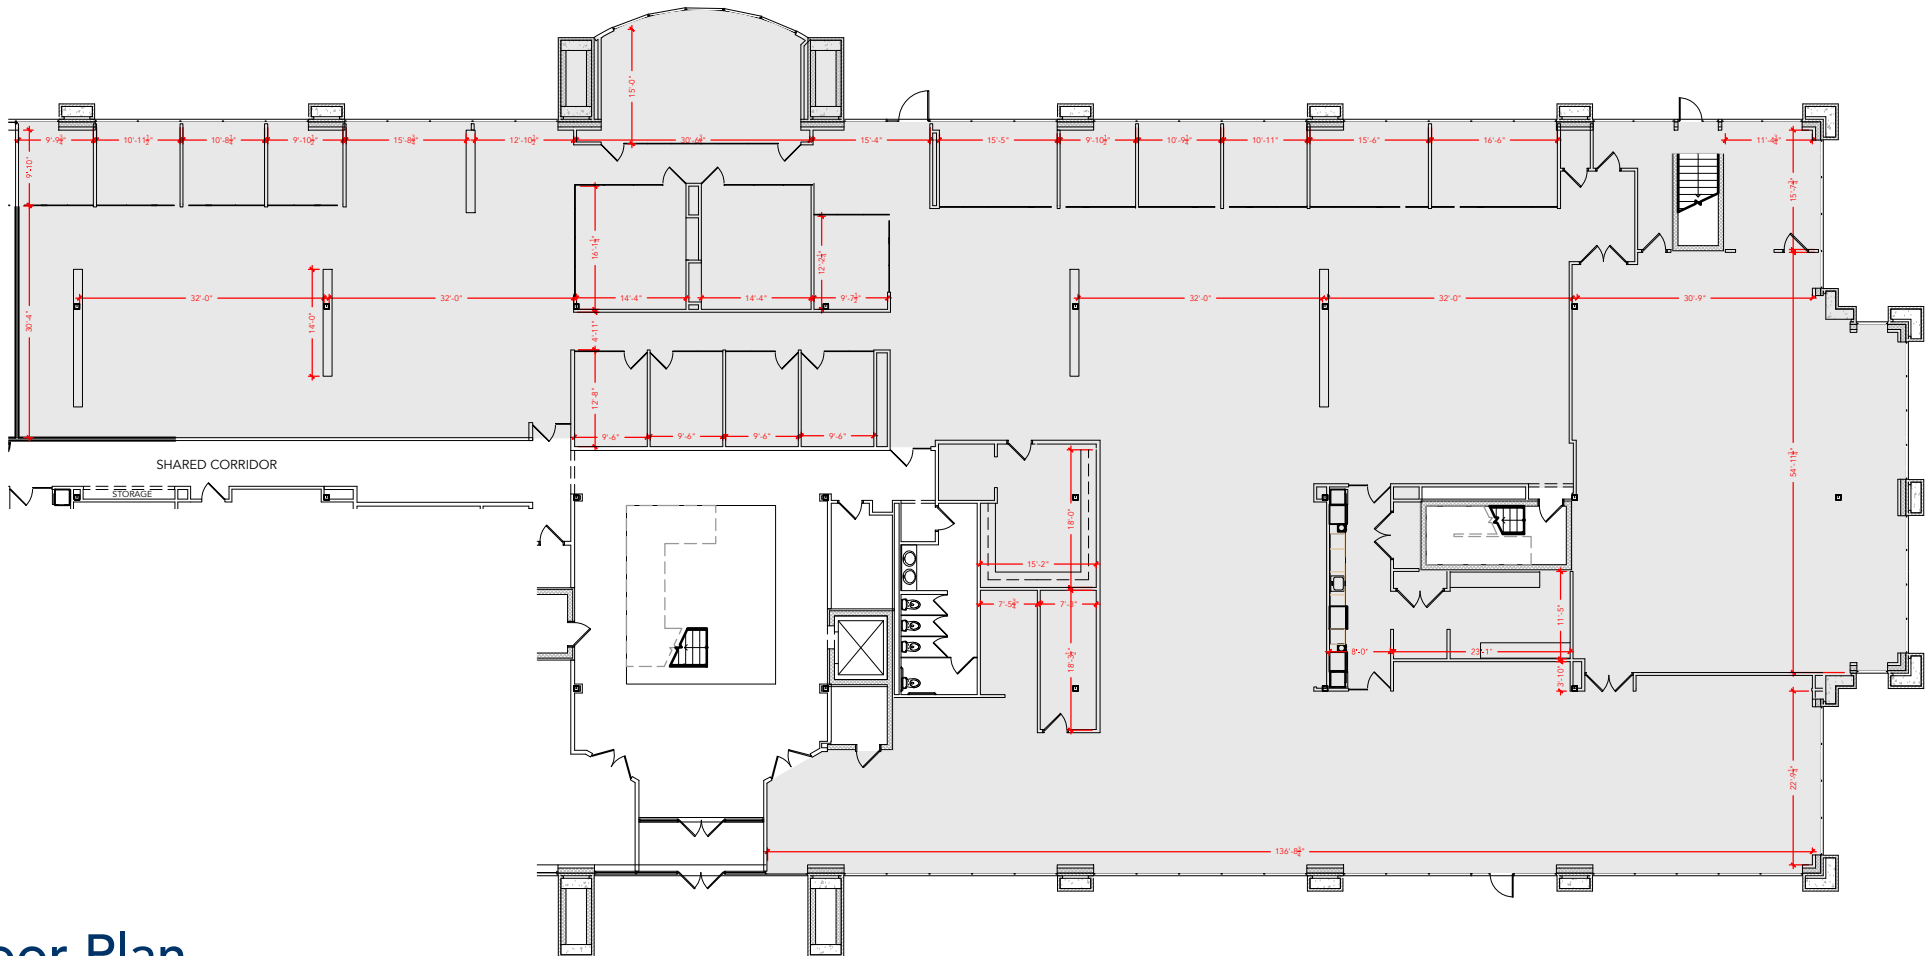

Floor Plan