


TOTAL SF AVAILABLE - 4,787 RSF (16%)

[Click to access CADD file](#)

Key Plan

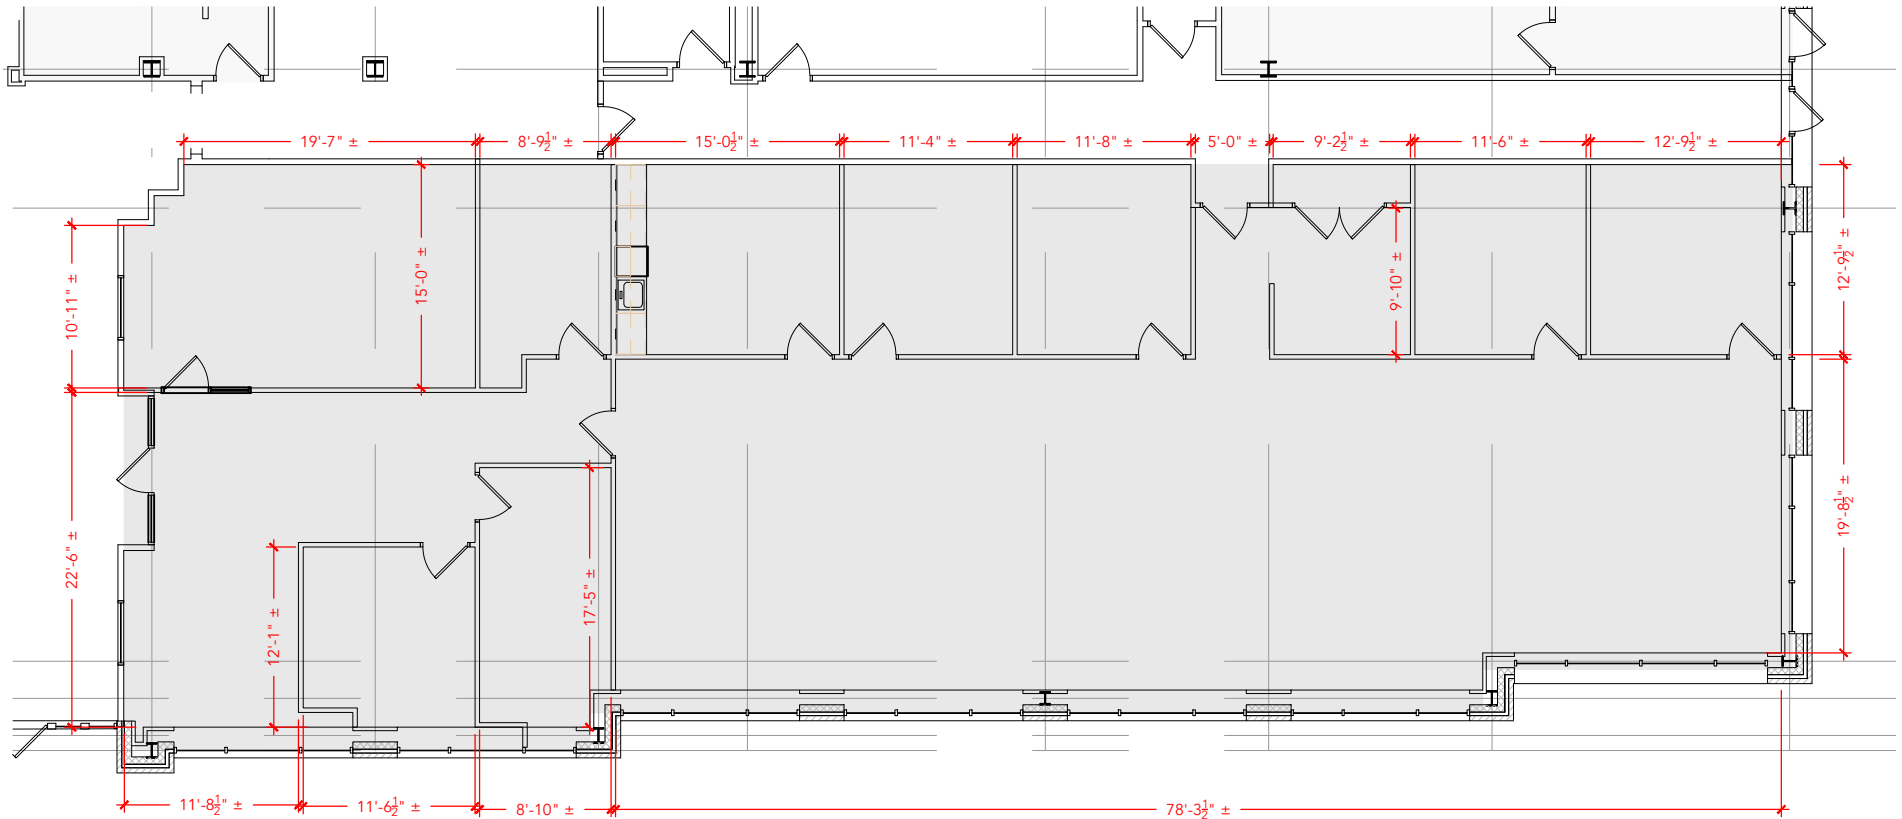

Floor Plan