
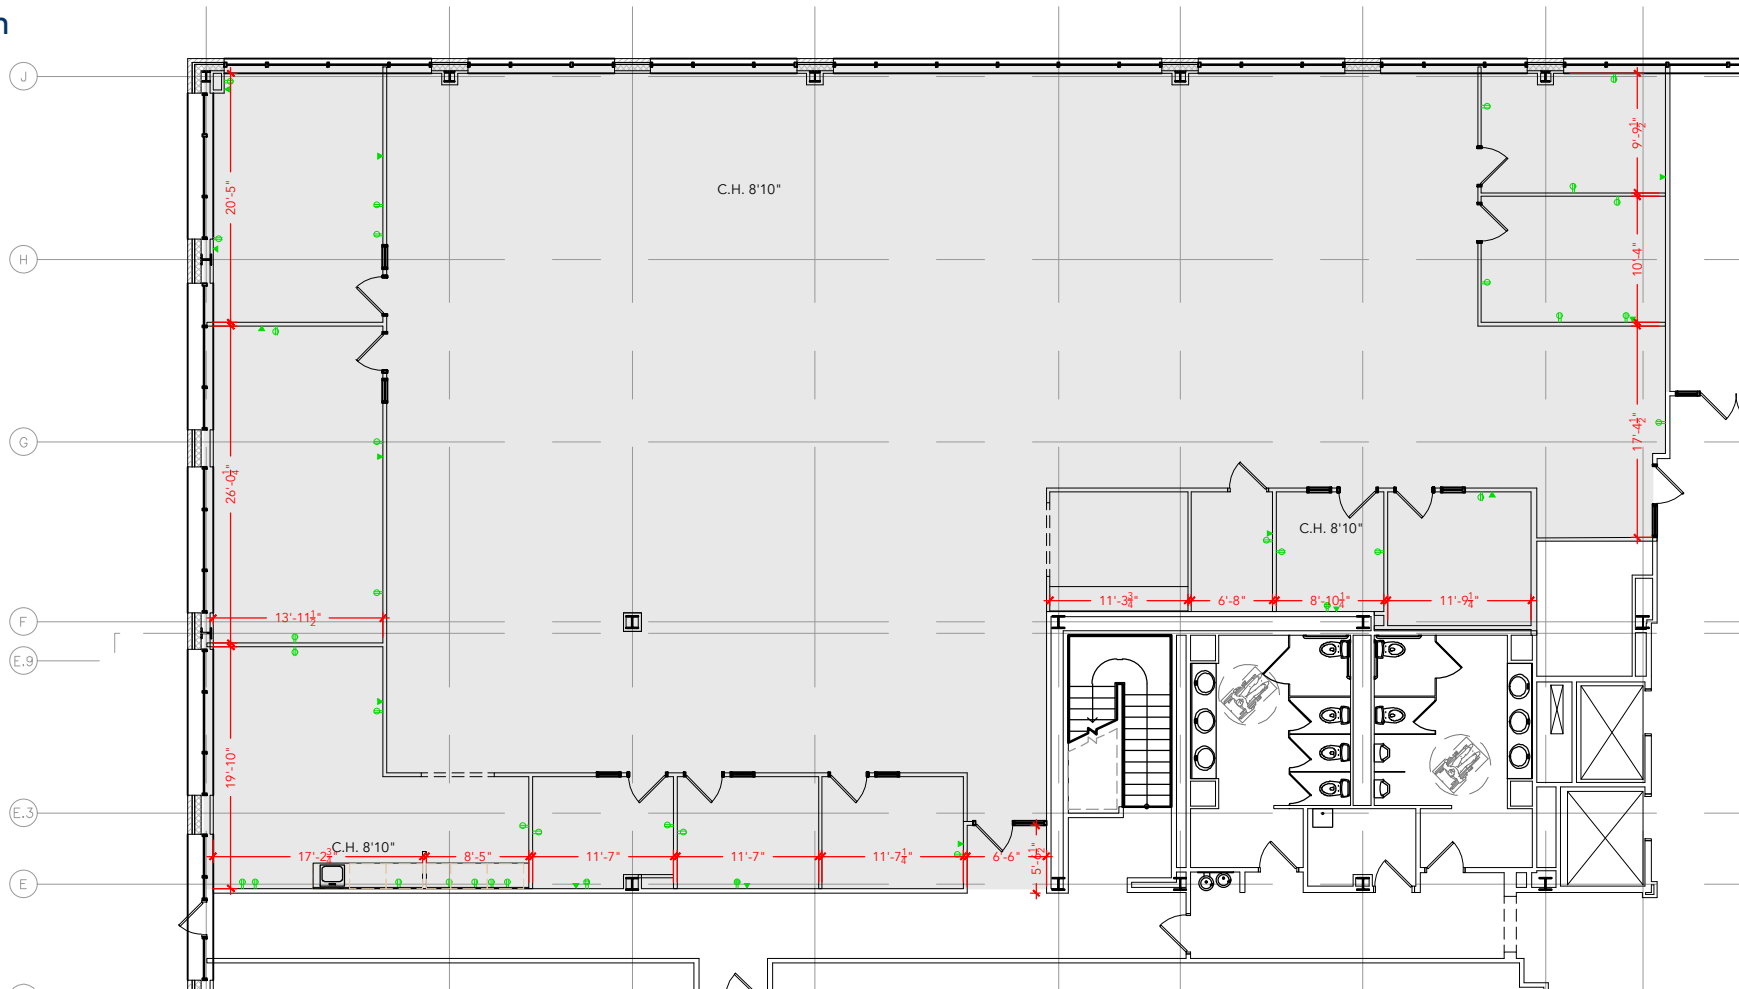


TOTAL SF AVAILABLE - 7,776 RSF(12.5%)

[Click to access 3D model](#)

Key Plan

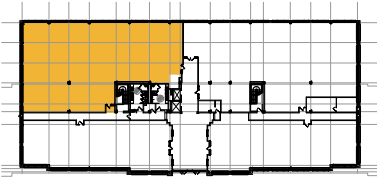

Floor Plan