



TOTAL SF AVAILABLE - 3,813 RSF(12.5%)

[Click to access 3D model](#)

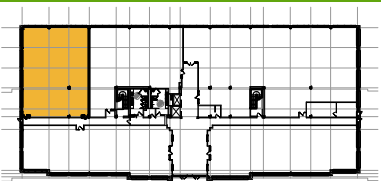

Key Plan

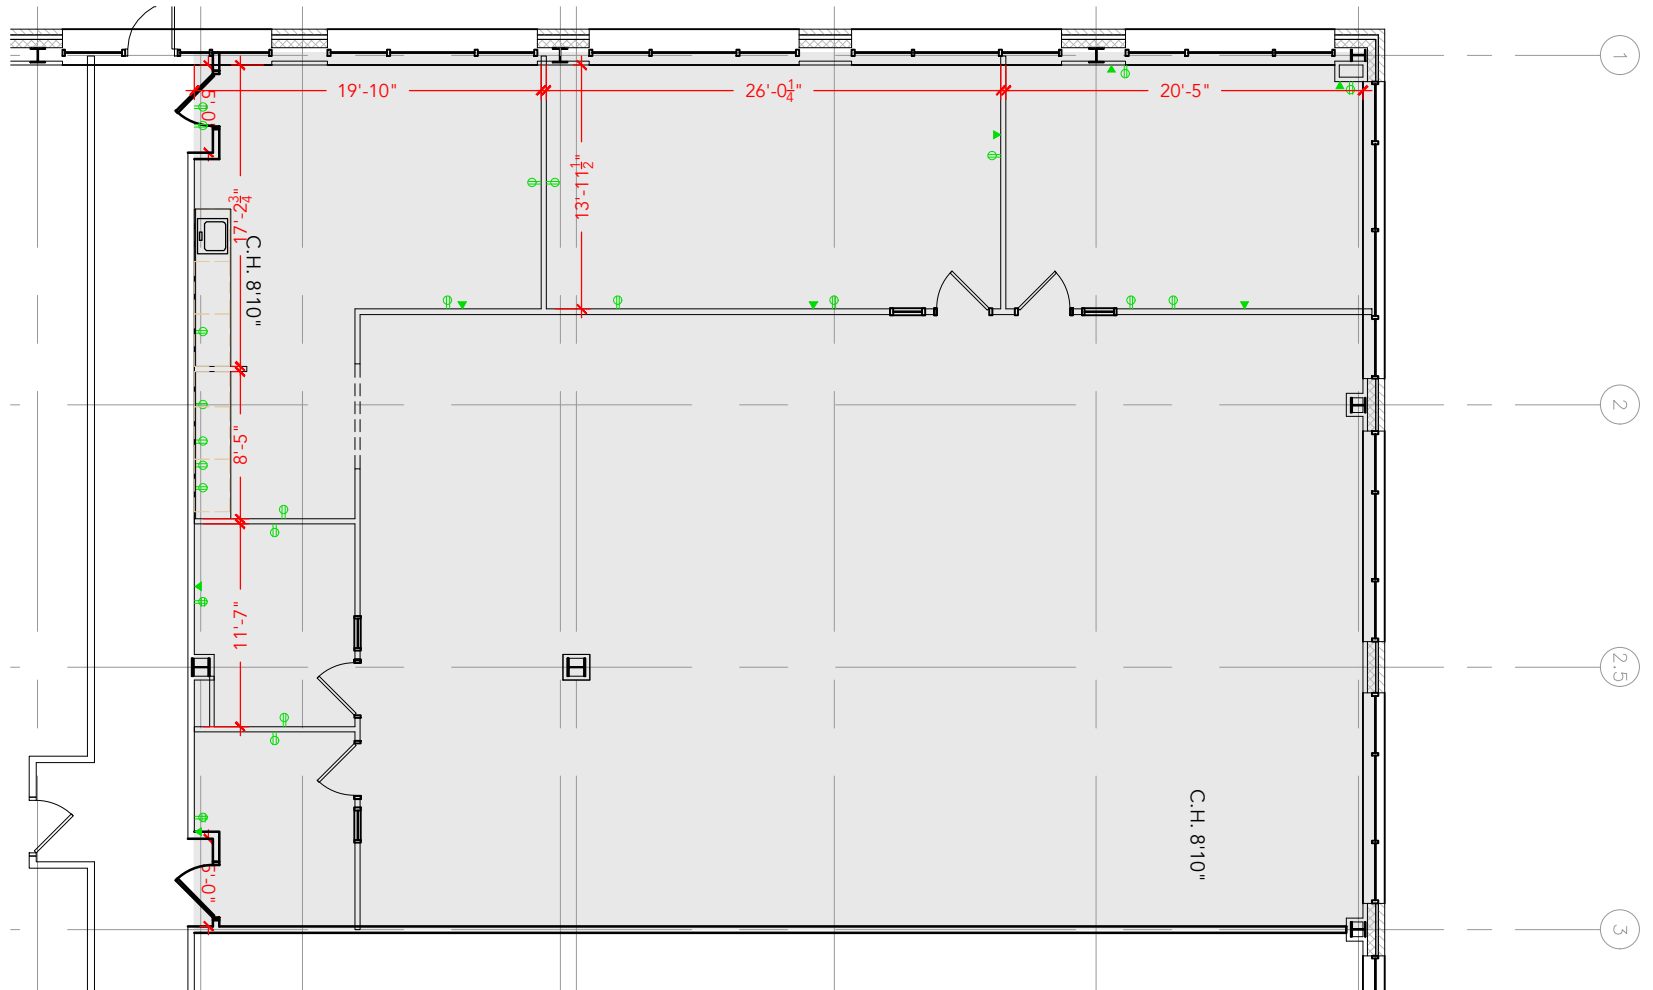

Floor Plan