
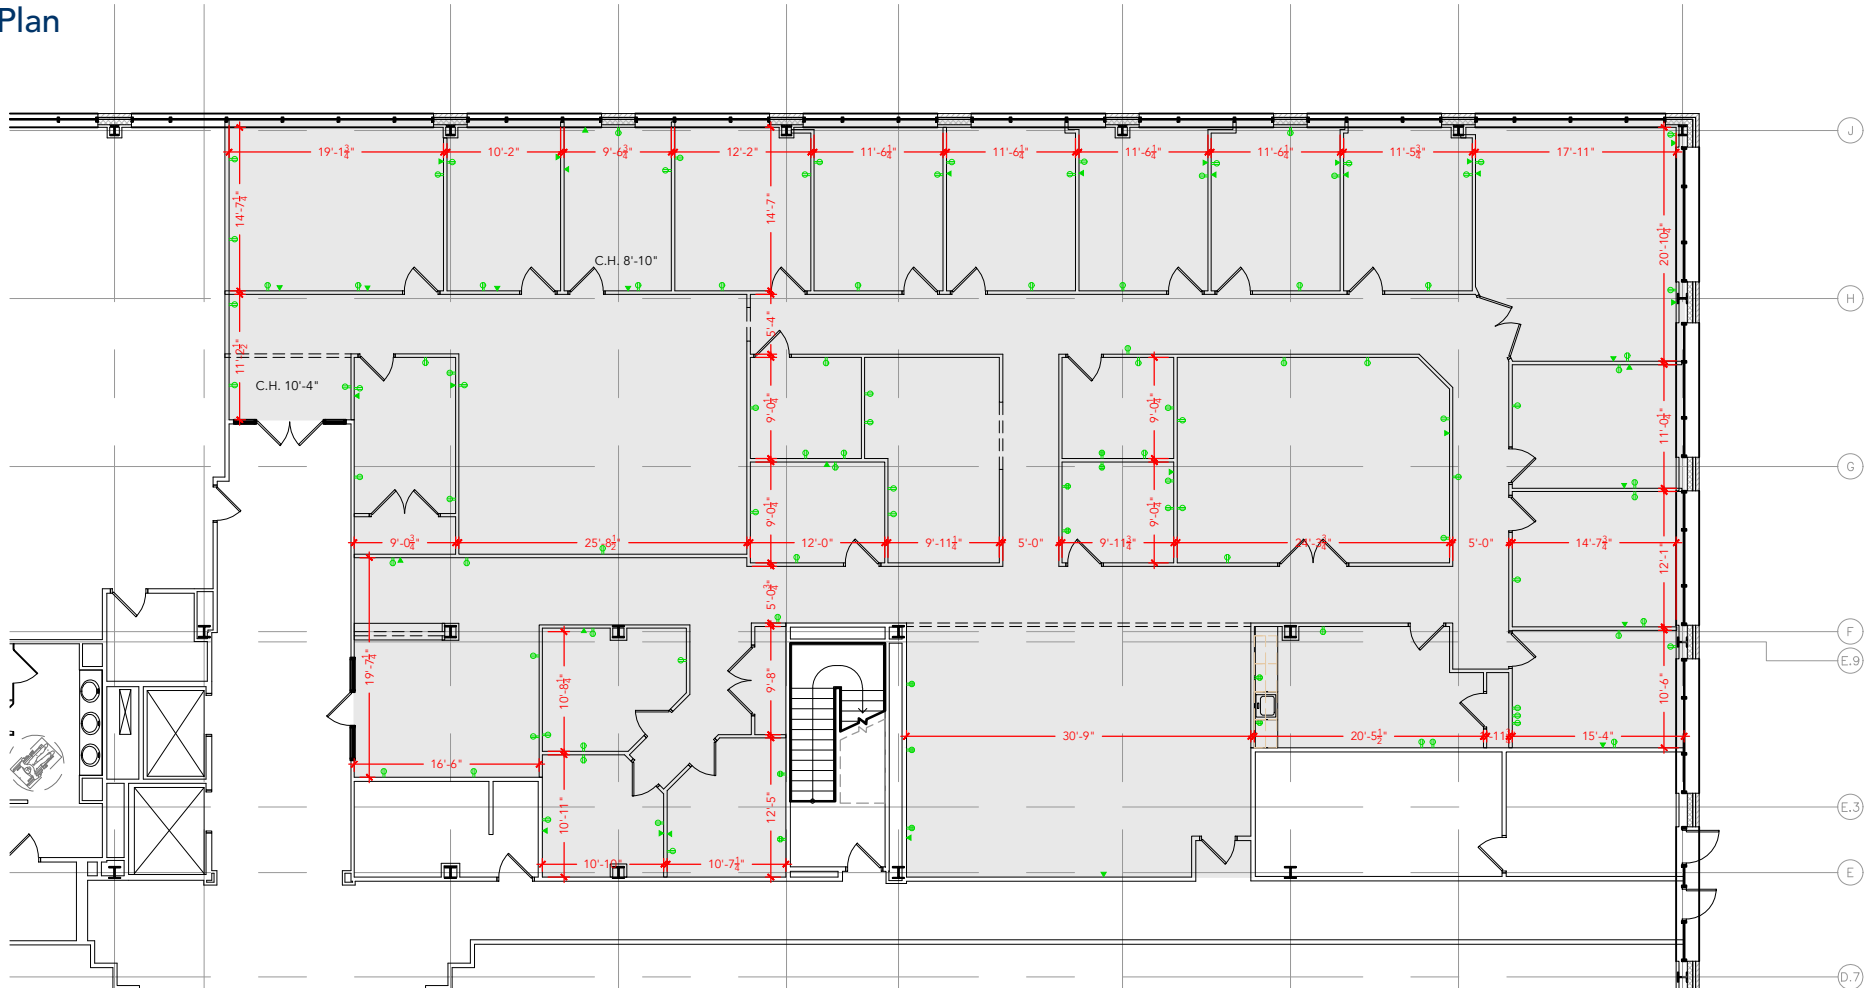


TOTAL SF AVAILABLE - 8,432 RSF(12.5%)

[Click to access 3D model](#)

Key Plan

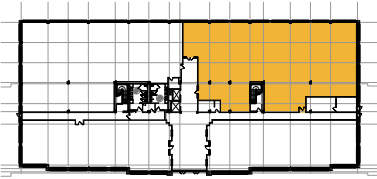

Floor Plan