
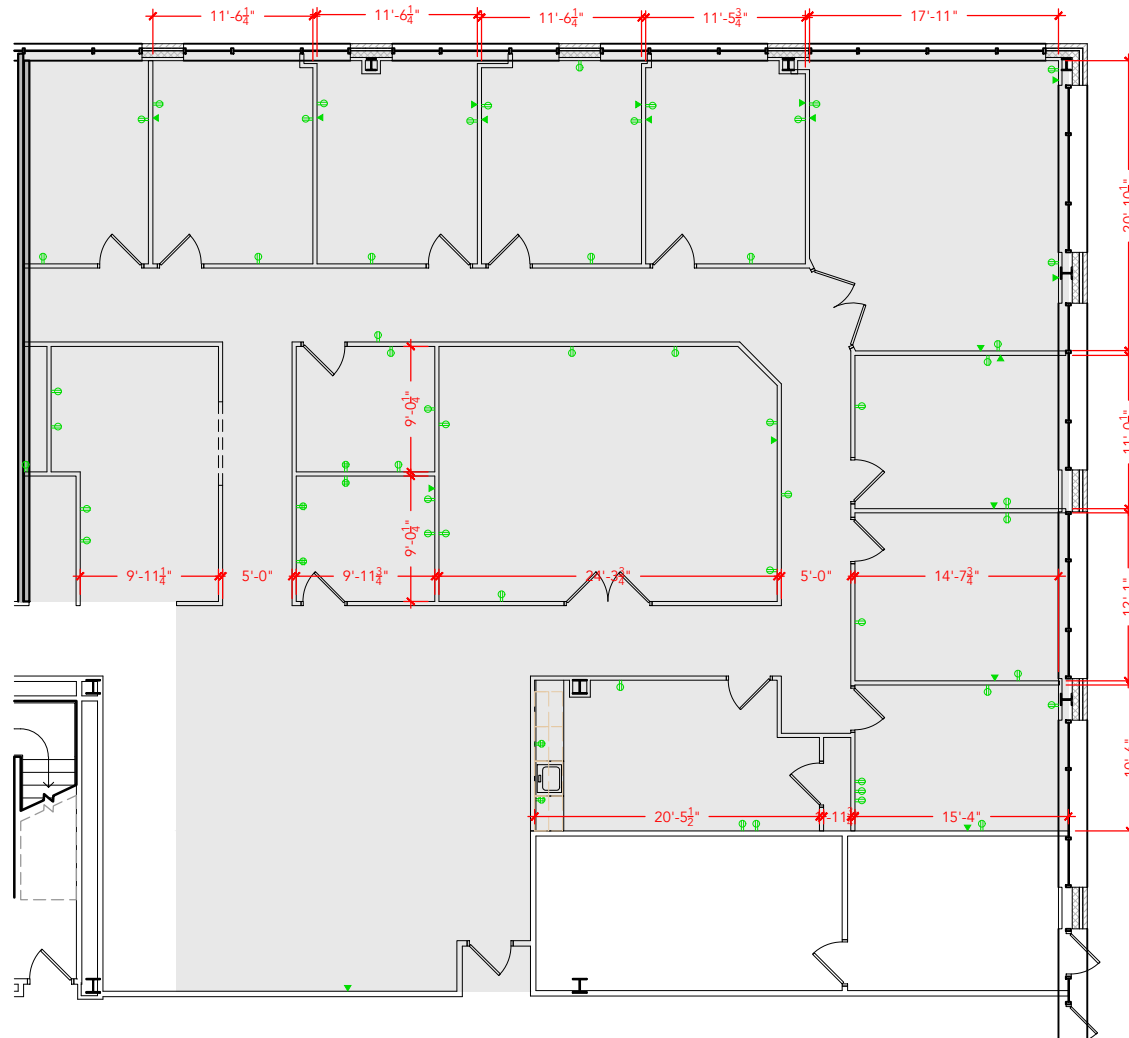


TOTAL SF AVAILABLE - 5,019 RSF(16%)

[Click to access 3D model](#)

Key Plan

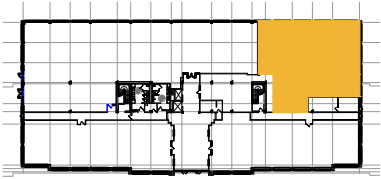

Floor Plan