


TOTAL SF AVAILABLE - 2,227 RSF(16%)

Key Plan

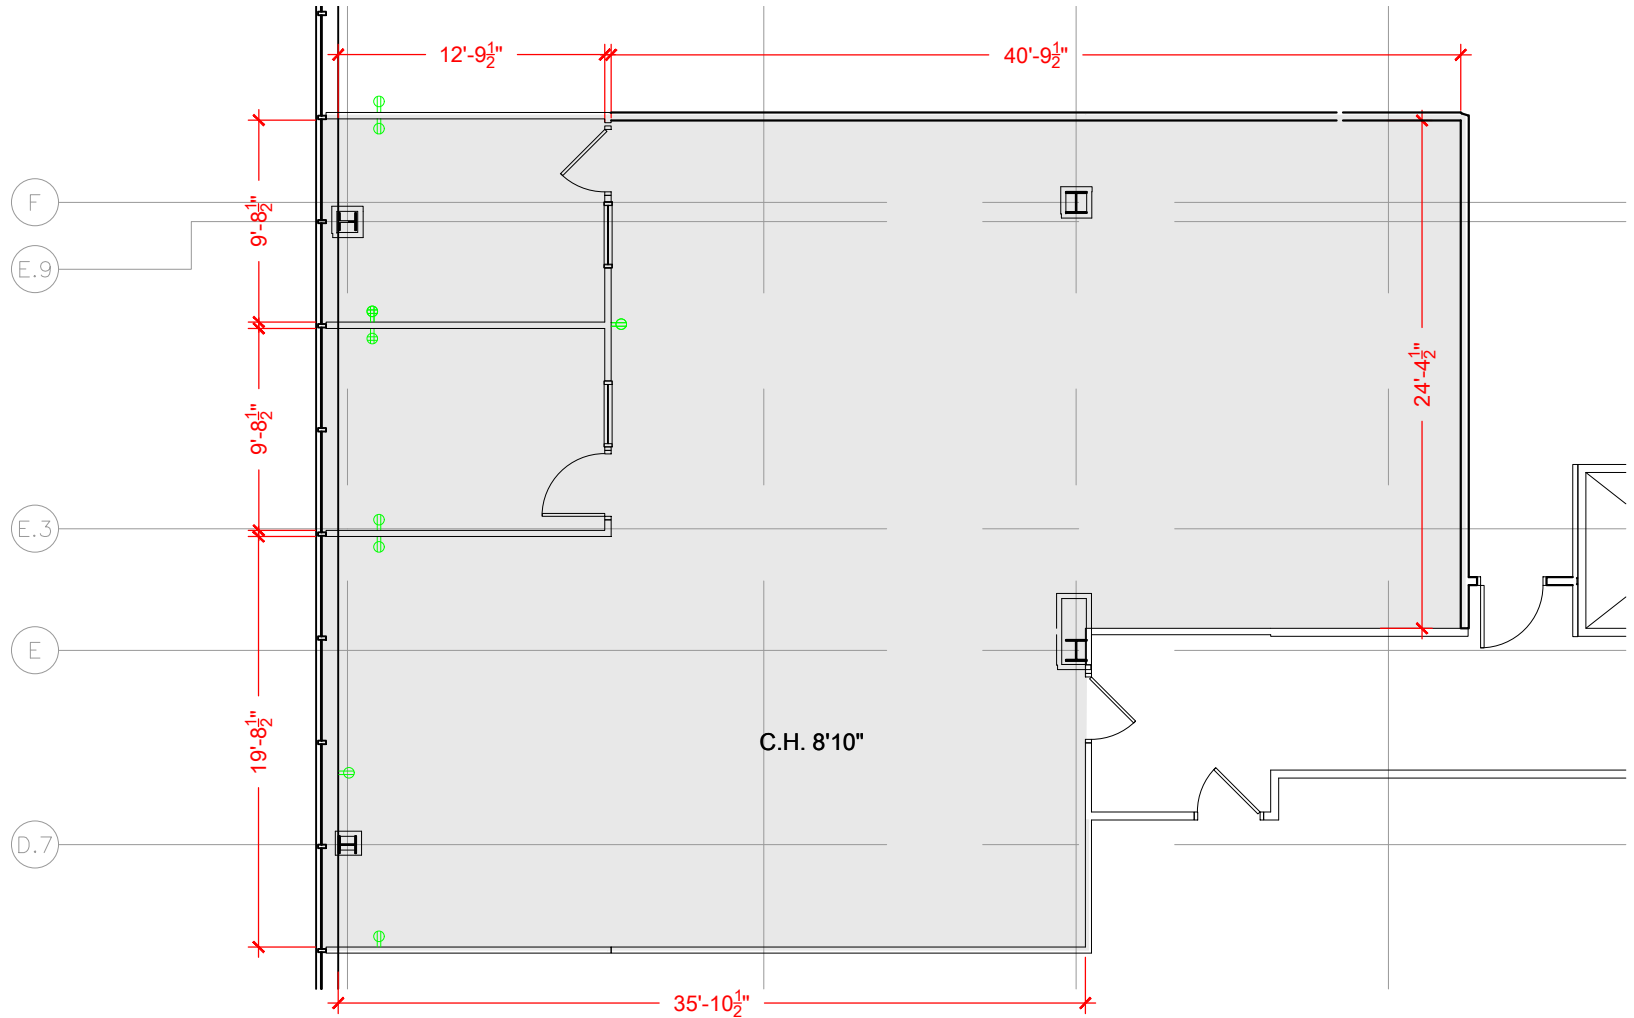

Floor Plan