


TOTAL SF AVAILABLE - 5,886 RSF(12.5%)



[Click to access 3D model](#)

Key Plan

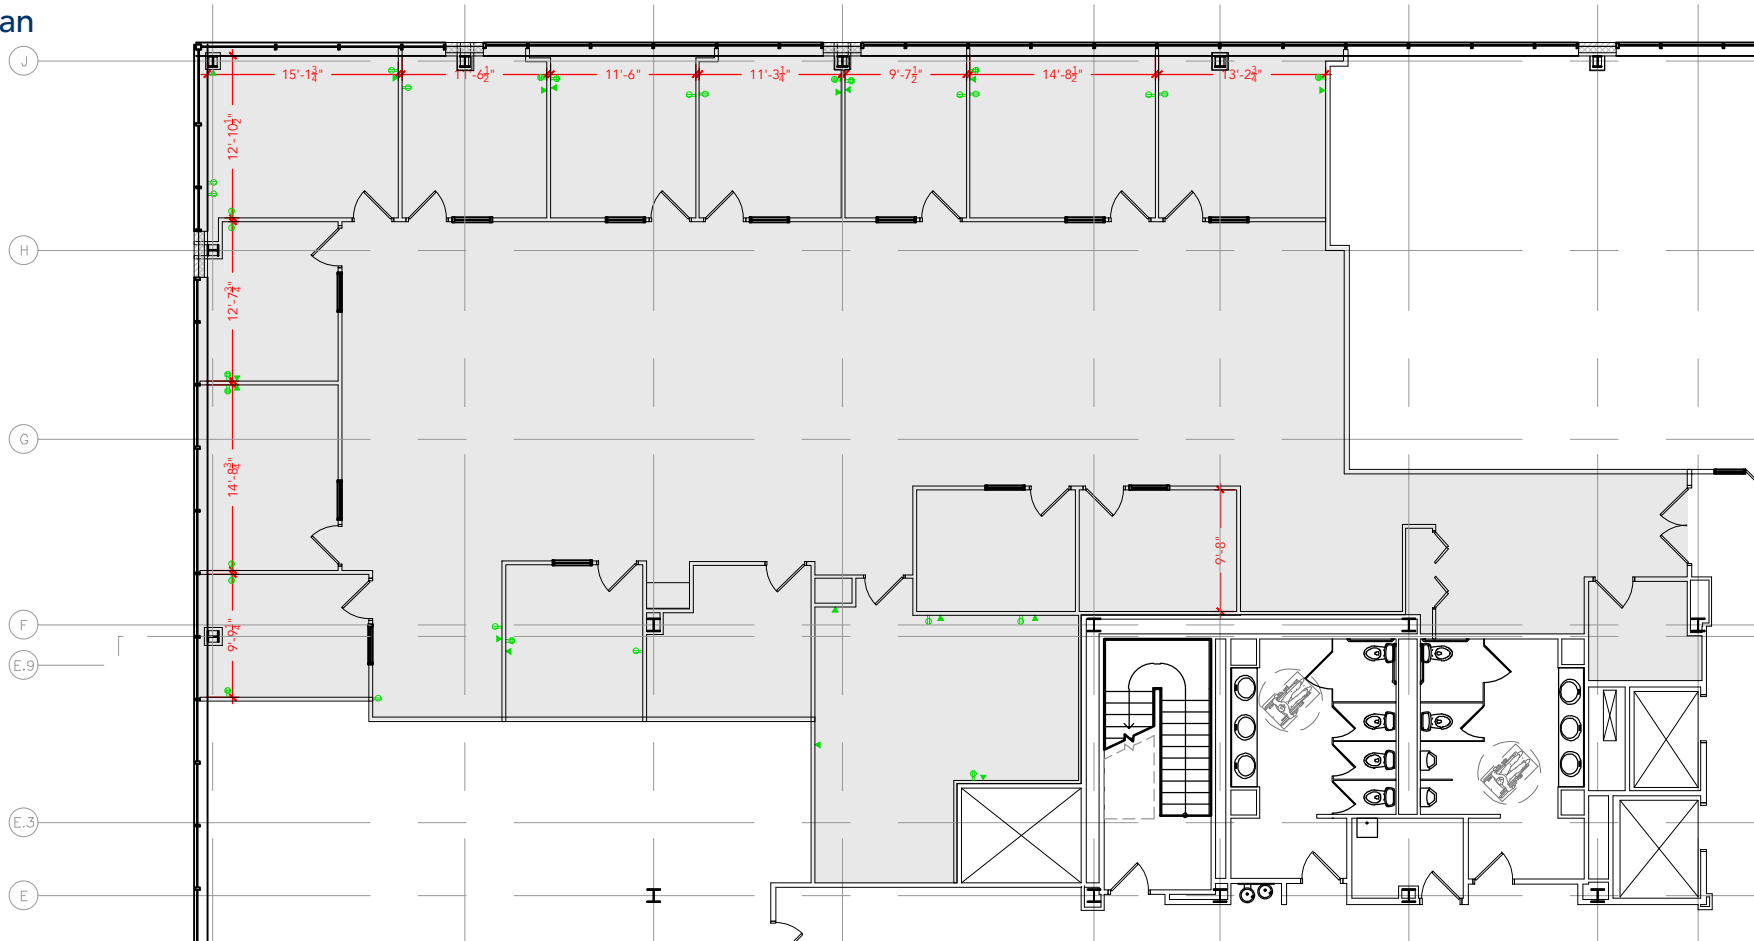

Floor Plan